LAND CORNER RECORDATION CERTIFICATE

Filing Requirement of Act 74, Mich. P.A. 1970

For corners in GLADWIN (County)

Located In:

Corner Code #

1. Public Land Survey		T 18N	R 1E	N-9	
		T	R		
		T	R		
		T	R		
2. Property Controlling	S 24	T	R	13, 16	
in Section	S	T	R		
3. Miscellaneous	S	T	R		
Property in Section	S	T	R		

Register of Deeds Stamp & File Number

4. Lot No. _____, Recorded Plat _____

5. Private Claims _____

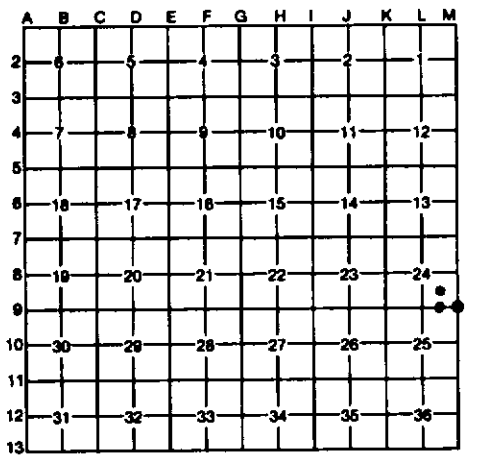

I, C.R. KIISKILA, in a field survey on JULY 20, 19 94, do hereby certify that under requirements of P.A. 74, Michigan P.A. of 1970, the corner points mentioned in lines 1 and 2 above were in conformance with regulations and rules therefore as required in the current manual of survey instructions of the United States Department of the Interior, Bureau of Land Management or by a decree of a Court of Law and/or that the corner points mentioned in lines 3, 4 and 5 above were in conformance with the rules of the Michigan Board of Professional Surveyors or by a Decree of a Court of Law; established, re-established, monumented, re-monumented, recovered, found as expressed below:

NOTE: Not more than 4 corners, all in the same town and range, may be recorded on this certificate.

A. Description of original monument and accessories and/or subsequent restoration:

N-9

(NO EVIDENCE OF G.L.O. CORNER, B.T'S, LINE TREES & TOPOGRAPHY, AS CALLED OUT IN THE G.L.O. LINE NOTES; UNLESS NOTED IN ITEM "B" BELOW.)

13

16

B. Description of corner evidence found and/or method applied in restoring or reestablishing corner:

N-9

FD 1/2" REROD FOR SE COR S-24 AS SET & RECORDED BY P.S, P.LAPHAM IN 1975. H.FLUHARTY 1978 COR REC. SAYS "FD 1/2" REBAR, RESET W/ 5/8"X 18" REBAR W/RLS CAP". CORNER IS IN APPROX. CTR OF N-S GRAVEL RD & 3' SOUTH OF CTR GRAVEL RD LOOKING TO EAST.

13

FD REROD W/PS, J.SEDGMAN CAP FOR CTR. OF SE1/4 OF S-24. COR FITS PROPER SUB'D OF SECTION PER BLM PROCEDURE AND ALSO CERT. OF SURVEY'S IN THE AREA BY PS, J.MEYERS. N'LY EDGE OF MOLASSES RIVER IS 18'± SOUTH. S'LY. EDGE OF BAYOU IS 16'± NORTH.

16

FD 1/2" REROD FOR SW COR OF SE1/4 OF SE1/4 OF S-24. COR FITS PROPER POSITION FOR STANDARD BLM PROCEDURE FOR SUB'D OF A SECTION. CORNER ALSO FITS CERT. OF SURVEY'S IN THE AREA BY PS, J.MEYERS.

C. Description of monument for corner and accessories established to perpetuate locating the position of the corner:

N-9

FD 1/2" REROD.

‡6" MAPLE(CLP5)	N75°W	59.25'
‡ POWER POLE	N20°W	73.42'
‡‡14" MAPLE	N35°E	85.65'
‡‡12" OAK(CLP4)	S40°E	107.23'
SET CED POST/W LOC TAG.	WEST	33'

‡=RLS P. LAPHAM 1975 WITS.
‡‡=PS, H.FLUHARTY 1978 WITS.

13

FD 1/2" REROD W/RLS CAP. ADDED CED POST W/LOC TAG.

16" SWP W OAK	SOUTH	7.90'
12" SWP W OAK	N22°W	8.45'
14" CEDAR	N42°E	13.52'
FD 1/2" REROD W/ RLS CAP.	EAST	13.0'
FD 1/2" REROD W/RLS CAP ON S'LY RD R/W. ADDED CED POST	N00°09'E	926.4

16

FD 1/2" X 18" REROD. ADDED 5/8" X 34" REROD W/PS CAP. SET CED POST W/LOC TAG.

‡ 9" TW MAPLE	S65°W	7.58'
‡ 7" MAPLE	N45°W	23.68'
‡15" MAPLE	N45°E	27.19'

‡WIT BY OTHERS.

STATE OF MICHIGAN
CARL KIISKILA
LAND SURVEYOR
No. 33981
LICENSED LAND SURVEYOR

Signed by Carl T. Kiiskila Date 3-28-97

Surveyor's Michigan License No. 33981

FORM APPROVED BY MICHIGAN STATE BOARD OF PROFESSIONAL SURVEYORS, JAN. 20, 1971
REVISED MAY 14, 1976
REVISED JAN., 1983