

OCT 23 1998

GLADWIN County Remonumentation

LAND CORNER RECORDATION CERTIFICATE
Filing Requirement of Act 74, Mich. P.A. 1970

LIBER 001 PAGE 239

SECTION

For corners in

<u>GLADWIN</u> (County)	Located in:	Corner Code #
1. Public Land Survey	T18N R02E	A-6
	T R	
	T R	
	T R	
2. Property Controlling in Section	S T R	
	S T R	
3. Miscellaneous Property in Sec.	S T R	
	S T R	

STATE OF MICHIGAN
GLADWIN COUNTY
FILED-CORNER

13 OCT 1998 12:50:14 PM

BONNIE K. HOUSE
REGISTER OF DEEDS

Register of Deeds Stamp & File Number

4. Lot No. _____, Recorded Plat _____
5. Private Claims _____

I, Mark R Robison, in a field survey on April _____, 1998 do hereby state that under requirements of P.A. 74, Michigan P.A. of 1970, the corner points mention in lines 1 and 2 above were in conformance with regulations and rules therefore as required in the current manual of survey instructions of the United States Department of the Interior, Bureau of Land Management or by a decree of a Court of Law and/or that the corner points mentioned in lines 3, 4 and 5 above were in conformance with the rules of the Michigan Board of Land Surveyors or by a Decree of a Court of Law; established, re-established, monumented, recovered, found as expressed below:

	A	B	C	D	E	F	G	H	I	J	K	L	M
1													
2	6		5		4		3		2		1		
3													
4	7		8		9		10		11		12		
5													
6	16		17		16		15		14		13		
7													
8	19		20		21		22		23		24		
9													
10	30		29		28		27		26		25		
11													
12	31		32		33		34		35		36		
13													

NOTE: Not more than 2 corners, all in the same town and range, may be recorded on this certificate

A. Description of original monument and accessories and/or subsequent restoration:

- A-6: 1837 Lewis Glason Set 1/4 Sec Post
- Wit-(1)Hem 12 N35W 15
- (2)Do 12 S71W 31

- 1992-97 DNR survey, work dwg, LCRC#364
- Set DNR Monument and Cedar Post
- Wit-(3)8" Maple N54W 16.4
- (4)9" Cedar N05E 28.5
- (5)11" Tamarack N15E 32.2
- (6)13" Maple N85E 13.2
- (7)4" R. Oak S30E 2.0

B. Description of corner evidence found and/or method applied in restoring or reestablishing corner:

- A-6: Found DNR monument as established M.O.L. 20 ft. West of brush line N-S on Northeasterly slope of ravine. Accepted corner and witnesses as found. Corner agrees with witnesses (3), (4), (5), (6) and (7).

See dossier and LCRC#364 for additional information.

C. Description of monument for corner and accessories established to perpetuate locating the position of the corner:


- A-6: W 1/4 Corner, Section 18. Found and accepted DNR cap (aluminum) on pipe and Cedar Post.

Witnesses:

- 8" Maple, blazed, N54W 16.4'
- 9" Cedar, blazed, N05E 28.5'
- 11" Tamarack, blazed, N15E 32.2'
- 4" Red Oak, blazed, S30E 2.0'
- 13" Sugar Maple, blazed, N85E 13.2'

APPROVED LAND CORNER
P.A. 315 of 1990
Gladwin County

Co. Rep. [Signature]
Date 8/14/98

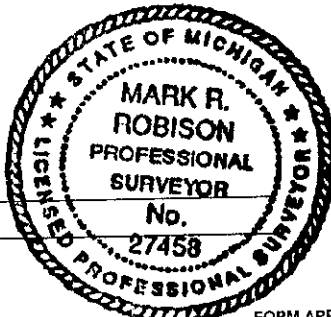

Signed by [Signature]
Surveyor's Michigan License No. 27458

Date 10-15-98