

**SURVEY & REMONUMENTATION**

**OCT 23 1998**

GLADWIN County Remonumentation

**SECTION**

**LAND CORNER RECORDATION CERTIFICATE**  
Filing Requirement of Act 74, Mich. P.A. 1970

LIBER **001** PAGE **240**

For corners in

<u>GLADWIN</u> (County)	Located in:	Corner Code #
1. Public Land Survey	T18N R02E	A-7
	T R	
	T R	
	T R	
2. Property Controlling in Section	S T R	
	S T R	
3. Miscellaneous Property in Sec.	S T R	
	S T R	

STATE OF MICHIGAN  
GLADWIN COUNTY  
FILED-CORNER

13 OCT 1998 12:50:26 PM

BONNIE K. HOUSE  
REGISTER OF DEEDS

Register of Deeds Stamp & File Number

4. Lot No. \_\_\_\_\_, Recorded Plat \_\_\_\_\_  
5. Private Claims \_\_\_\_\_

I, Mark R Robison, in a field survey on June \_\_\_\_\_, 1998, do hereby state that under requirements of P.A. 74, Michigan P.A. of 1970, the corner points mention in lines 1 and 2 above were in conformance with regulations and rules therefore as required in the current manual of survey instructions of the United States Department of the Interior, Bureau of Land Management or by a decree of a Court of Law and/or that the corner points mentioned in lines 3, 4 and 5 above were in conformance with the rules of the Michigan Board of Land Surveyors or by a Decree of a Court of Law; established, re-established, monumented, recovered, found as expressed below:

1	A	B	C	D	E	F	G	H	I	J	K	L	M
2		6		5		4		3		2		1	
3													
4		7		8		9		10		11		12	
5													
6		18		17		16		15		14		13	
7													
8		19		20		21		22		23		24	
9													
10		30		29		28		27		26		25	
11													
12		31		32		33		34		35		36	
13													

**NOTE: Not more than 2 corners, all in the same town and range, may be recorded on this certificate**

A. Description of original monument and accessories and/or subsequent restoration:  
**A-7:** 1836 Lewis Glason  
 Set Post Sec's 13 & 24 on NW bank 45 W of True Corner  
 Wit-(1)Lynn 10 N16E 6  
 (2)Cedar 7 S41W 26  
 1975 Lapham working dwg  
 Set 5/8" Iron per section subdivision  
 Wit-(3)14" Cedar North 98.95  
 (4)8" Cedar N45E 58.25  
 (5)6" Cedar S35W 33.20  
 1978 Fluharty LCRC#216 Fd 1/2" rebar  
 Wit-(6)9" Maple N60W 35.06  
 (7)11" Cedar N55E 58.69  
 (8)9" Cedar S35W 33.51  
 1992-97 DNR survey & LCRC#364  
 Fd 1/2" rerod; Drove 1" x 60" Galv Pipe  
 Wit-(9)14" Maple N60W 34.4  
 (10)12" Tw Cedar Stp N60E 32.67  
 (11)19" Pine N70E 52.6  
 (12)12" Cedar S35W 32.8

B. Description of corner evidence found and/or method applied in restoring or reestablishing corner:  
**A-7:** Found DNR 1" x 60" Galvanized Pipe with DNR Monument Cap over 1/2" rerod. Agrees with witnesses (6), (7), (9), (10), (11) & (12)-witnesses were blazes only except for witness (8). Corner 50 +/- feet East of the River.

See dossier for additional details.

C. Description of monument for corner and accessories established to perpetuate locating the position of the corner:  
**A-7:** Corner common to Sections 18 & 19, on township line. Accepted found DNR Monument as found in place.


Witnesses:  
 N60W 14" Maple, nail & tag, 34.87'  
 S35W 12" Cedar, nail & tag, 33.40'  
 N75E 14" Elm, nail & tag, 10.42'  
 N60E 12" Twin Cedar Stump, spike, 32.67'

**APPROVED LAND CORNER**

P.A. 315 of 1990  
Gladwin County

Co. Rep. [Signature]  
Date 8/11/98

Signed by [Signature]  
Surveyor's Michigan License No. 27458

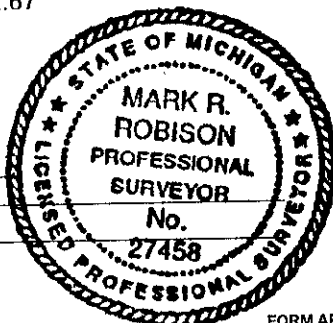

Date 10-5-98