SURVEY & REMONUMENTATION

OCT 23 1998

SECTION

GLADWIN County Remonumentation

LAND CORNER RECORDATION CERTIFICATE
Filing Requirement of Act 74, Mich. P.A. 1970

LIBER 001 PAGE 242

STATE OF MICHIGAN
GLADWIN COUNTY
FILED-CORNER

13 OCT 1998 12:50:57 PM

BONNIE K. HOUSE
REGISTER OF DEEDS

Register of Deeds Stamp & File Number

For corners in

GLADWIN
(County)

	Located in:	Corner Code #
1. Public Land Survey	T18N R02E	A-9
	T___R___	
	T___R___	
	T___R___	
2. Property Controlling in Section	S___ T___R___	
	S___ T___R___	
	S___ T___R___	
3. Miscellaneous Property in Sec.	S___ T___R___	

4. Lot No._____, Recorded Plat_____
5. Private Claims_____

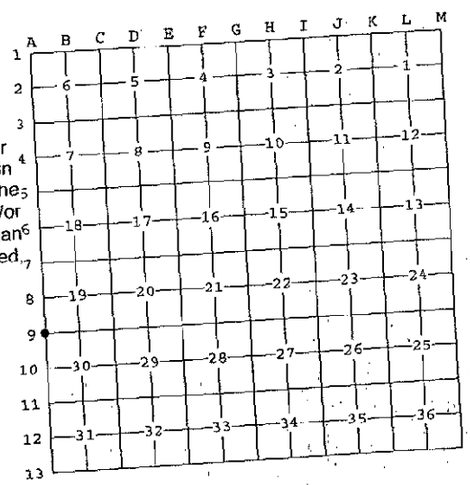

I, Mark R Robison, in a field survey on April ____, 19 98 do hereby state that under requirements of P.A. 74, Michigan P.A. of 1970, the corner points mention in lines 1 and 2 above were in conformance with regulations and rules therefore as required in the current manual of survey instructions of the United States Department of the Interior, Bureau of Land Management or by a decree of a Court of Law and/or that the corner points mentioned in lines 3, 4 and 5 above were in conformance with the rules of the Michigan Board of Land Surveyors or by a Decree of a Court of Law; established, re-established, monumented, recovered, found as expressed below:

NOTE: Not more than 2 corners, all in the same town and range, may be recorded on this certificate

A. Description of original monument and accessories and/or subsequent restoration:

A-9: 1837 Lewis Glason
Set Post Sec's 24 & 25
Wit-(1)W. Pine 22 N45W 16
(2)Do 18 S52W 22

1975 Lapham LCRC#116 Set C.I.
Wit-(3)N30W 73.45 P.P.
(4)N80W 59.25 C. Maple
(5)N80E 31.80 Yield sign
1975 Lapham working drawing

1977 Fluharty LCRC#214 Set 5/8" x 18"
rebar over found bent 1/2" x 18" rebar
Wit-(6)7" Maple in cluster S45E 107.50
(7)12" Maple N35E 86.32
(8)U. Pole N18W 73.42

1992-97 DNR surv &LCRC#439 Fd 1/2" rerod
Wit-(9)6" Maple (CLP5) N75W 59.25
(10)P.P. N20W 73.42
(11)14" Maple N35E 85.65
(12)12" Oak (CLP4) S40E 107.23

1997 Lapham survey Fd DNR capped iron
Wit-(13)West 33.34 DNR Post
(14)N30W 73.47 P.P.
(15)N30E 85.80 10" Oak
(16)S40E 107.25 10" Oak

B. Description of corner evidence found and/or method applied in restoring or reestablishing corner:
A-9: Found 1/2" rerod capped DNR 0.5 ft. below surface of asphalt road N-S and 3 ft. South of gravel road East. Corner agrees with witnesses (3), (4), (11), and (12).

See dossier for detailed report.

C. Description of monument for corner and accessories established to perpetuate locating the position of the corner:
A-9: Corner common to Sections 19 and 30 on township line. Set 5/8" x 36" rerod (in place of found 1/2" rerod) with Gladwin County Remonumentation cap marked P.S.#27458 in Monument Box.

Witnesses:
N75W 6" Maple (CLP5), spike, 59.28'
N15W U. Pole, nail & tag, 73.45'
N35E 14" Maple, spike, 85.86'
S40E 10" Oak, spike, 107.25'

APPROVED LAND CORNER
P.A. 345 of 1990
Gladwin County

Co. Rep. [signature]
Date 8/11/99

STATE OF MICHIGAN
MARK R. ROBISON
PROFESSIONAL SURVEYOR
No. 27458
LICENSED PROFESSIONAL SURVEYOR

Signed by [signature]
Surveyor's Michigan License No. 27458

Date 10-5-98

FORM APPROVED BY MICHIGAN STATE BOARD OF PROFESSIONAL SURVEYORS, JAN. 26, 197
REVISED MAY 14,197
REVISED JAN., 198
REVISED OCT., 199