

SURVEY & REMONUMENTATION

OCT 23 1998

SECTION

GLADWIN County Remonumentation

LIBER 001 PAGE 245

LAND CORNER RECORDATION CERTIFICATE
Filing Requirement of Act 74, Mich. P.A. 1970

For corners in

GLADWIN
(County)

Located in:

Corner Code #

- 1. Public Land Survey T18N R02E B-9
- T R _____
- T R _____
- T R _____
- 2. Property Controlling S T R _____
- in Section S T R _____
- 3. Miscellaneous S T R _____
- Property in Sec. S T R _____

STATE OF MICHIGAN
GLADWIN COUNTY
FILED-CORNER

13 OCT 1998 12:52:02 PM

BONNIE K. HOUSE
REGISTER OF DEEDS

Register of Deeds Stamp & File Number

- 4. Lot No. _____, Recorded Plat _____
- 5. Private Claims _____

I, Mark R Robison, in a field survey on April _____, 1998 do hereby state that under requirements of P.A. 74, Michigan P.A. of 1970, the corner points mention in lines 1 and 2 above were in conformance with regulations and rules therefore as required in the current manual of survey instructions of the United States Department of the Interior, Bureau of Land Management or by a decree of a Court of Law and/or that the corner points mentioned in lines 3, 4 and 5 above were in conformance with the rules of the Michigan Board of Land Surveyors or by a Decree of a Court of Law; established, re-established, monumented, recovered, found as expressed below:

	A	B	C	D	E	F	G	H	I	J	K	L	M
1													
2	6		5		4		3		2		1		
3													
4	7		8		9		10		11		12		
5													
6	18		17		16		15		14		13		
7													
8	19		20		21		22		23		24		
9													
10	30		29		28		27		26		25		
11													
12	31		32		33		34		35		36		
13													

NOTE: Not more than 2 corners, all in the same town and range, may be recorded on this certificate

A. Description of original monument and accessories and/or subsequent restoration:

B-9: 1846 John Mullett Set 1/4 Sec Post
Wit-(1)Maple 12 N72E 42
(2)Do 6 S67W 15

1992-97 DNR survey & LCRC#426
Fd 1/2" rerod
Wit-(3)7" Elm N40E 52.19
(4)2" Ash S15E 60.33
(5)6" Ash S65W 79.94
Set Post with loc tag South 33'

B. Description of corner evidence found and/or method applied in restoring or reestablishing corner:

B-9: Found 5/8" x 36" rerod with P.S. Cap 3 ft. North of centerline of gravel road. Corner agrees with DNR witnesses. Corner is part of large retracement of T18N, R2E by the DNR.

See dossier and LCRC#426 for additional information.


C. Description of monument for corner and accessories established to perpetuate locating the position of the corner:

B-9: Corner common to Sections 19 & 30. Set Gladwin County Remonumentation cap marked P.S.#27458 over found 5/8" x 36" rerod.

APPROVED LAND CORNER
P.A. 345 of 1990
Gladwin County

Co/Rep [Signature]
Date 8/11/98

- Witnesses:
- S40E 7" Elm, nail & tag, 51.92' - N.B.T.
 - S15E 2" Elm, nail & tag, 60.40' - N.B.T.
 - S65W 6" Ash, nail & tag, 79.78' - N.B.T.
 - South 8" Post, nail & tag, 33.18'

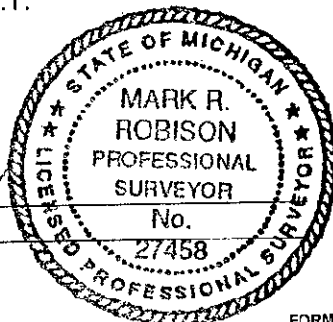

Signed by [Signature]
Surveyor's Michigan License No. 27458

Date 10-5-98