

SURVEY & REMONUMENTATION

OCT 23 1998

GLADWIN County Remonumentation
LAND CORNER RECORDATION CERTIFICATE
 Filing Requirement of Act 74, Mich. P.A. 1970

LIBER 001 PAGE 247

For corners in **SECTION**

<u>GLADWIN</u> (County)	Located in:	Corner Code #
1. Public Land Survey	T18N R02E	C-5
	T R	
	T R	
	T R	
2. Property Controlling in Section	S T R	
	S T R	
3. Miscellaneous Property in Sec.	S T R	
	S T R	

STATE OF MICHIGAN
 GLADWIN COUNTY
 FILED-CORNER

13 OCT 1998 12:52:27 PM

BONNIE K. HOUSE
 REGISTER OF DEEDS

Register of Deeds Stamp & File Number

4. Lot No. _____, Recorded Plat _____
 5. Private Claims _____

I, Mark R Robison, in a field survey on April _____, 1998, do hereby state that under requirements of P.A. 74, Michigan P.A. of 1970, the corner points mention in lines 1 and 2 above were in conformance with regulations and rules therefore as required in the current manual of survey instructions of the United States Department of the Interior, Bureau of Land Management or by a decree of a Court of Law and/or that the corner points mentioned in lines 3, 4 and 5 above were in conformance with the rules of the Michigan Board of Land Surveyors or by a Decree of a Court of Law; established, re-established, monumented, recovered, found as expressed below:

1	A	B	C	D	E	F	G	H	I	J	K	L	M
2		5		5		4		3		2		1	
3													
4	7		8		9		10		11		12		
5													
6	18		17		16		15		14		13		
7													
8	19		20		21		22		23		24		
9													
10	30		29		28		27		26		25		
11													
12	31		32		33		34		35		36		
13													

NOTE: Not more than 2 corners, all in the same town and range, may be recorded on this certificate

A. Description of original monument and accessories and/or subsequent restoration:

- C-5:** 1846 John Mullett
 Set Post Cor Sec's 7, 8, 17 & 18
 Wit-(1)Y. Pine 10 S18W 27
 (2)Do 12 N39E 68
 1996 Lapham (2 surveys)
 Fd 1" Capped Pipe
 Wit-same as (3),(4),(5)&(6)
- 1992-97 DNR survey & LCRC#365 Fd 3/8" Rod
 Drove 1" x 36" Galv Pipe over fd Iron
 Wit-(3)15" R. Pine S85E 53.2
 (4)20" Oak N60E 60.00
 (5)2" Maple N25W 85.6
 (6)2" Cherry S65W 67.5

B. Description of corner evidence found and/or method applied in restoring or reestablishing corner:

- C-5:** Found 1" pipe, set by DNR over found 3/8" rod. Corner in approximately centerline of North-South county road and 3 ft. North of road West. Corner is part of large retracement by DNR. Agrees with retracement by J. Meyers P.S.#14099. Corner agrees with DNR witnesses. See dossier and LCRC#365 for additional information.

C. Description of monument for corner and accessories established to perpetuate locating the position of the corner:

- C-5:** Corner common to Sections 7, 8, 17 & 18. Set 5/8" x 12" rod with Gladwin County Remonumentation cap marked P.S.#27458 in found 1" Pipe.

Witnesses:

- S85E 15" R. Pine, nail & tag, 53.60'
 N60E 20" Oak, nail & tag, 60.23'
 N40E 18" Oak, nail & tag, 73.05'
 S65E 30" Oak, nail & tag, 89.78'


APPROVED LAND CORNER

P.A. 345 of 1990
 Gladwin County

Co. Rep. J. Meyers

Date 8/14/98

Signed by Mark R Robison
 Surveyor's Michigan License No. 27458

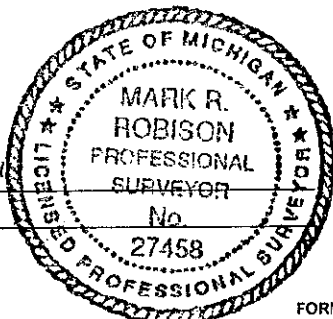

Date 10-5-98