

OCT 23 1998

GLADWIN County Remonumentation

LIBER 001 PAGE 248

**LAND CORNER RECORDATION CERTIFICATE**  
Filing Requirement of Act 74, Mich. P.A. 1970

**SECTION**

For corners in

<u>GLADWIN</u> (County)	Located in:	Corner Code #
1. Public Land Survey	T18N R02E	C-6
	T ___ R ___	_____
	T ___ R ___	_____
	T ___ R ___	_____
2. Property Controlling in Section	S ___ T ___ R ___	_____
	S ___ T ___ R ___	_____
3. Miscellaneous Property in Sec.	S ___ T ___ R ___	_____
	S ___ T ___ R ___	_____

STATE OF MICHIGAN  
GLADWIN COUNTY  
FILED-CORNER

13 OCT 1998 12:52:39 PM

BONNIE K. HOUSE  
REGISTER OF DEEDS

Register of Deeds Stamp & File Number

4. Lot No. \_\_\_\_\_, Recorded Plat \_\_\_\_\_  
5. Private Claims \_\_\_\_\_

I, Mark R Robison, in a field survey on April \_\_\_\_\_, 1998 do hereby state that under requirements of P.A. 74, Michigan P.A. of 1970, the corner points mention in lines 1 and 2 above were in conformance with regulations and rules therefore as required in the current manual of survey instructions of the United States Department of the Interior, Bureau of Land Management or by a decree of a Court of Law and/or that the corner points mentioned in lines 3, 4 and 5 above were in conformance with the rules of the Michigan Board of Land Surveyors or by a Decree of a Court of Law; established, re-established, monumented, recovered, found as expressed below:

1	A	B	C	D	E	F	G	H	I	J	K	L	M
2	6		5		4		3		2		1		
3													
4	7		8		9		10		11		12		
5													
6	18		17		16		15		14		13		
7													
8	19		20		21		22		23		24		
9													
10	30		29		28		27		26		25		
11													
12	31		32		33		34		35		36		
13													

**NOTE: Not more than 2 corners, all in the same town and range, may be recorded on this certificate**

**A. Description of original monument and accessories and/or subsequent restoration:**

- C-6:** 1846 John Mullett Set 1/4 Sec Post  
Wit-(1)W Pine 8 S30E 40  
(2)Y Pine 18 S77W 17
- 1992-97 DNR survey & LCRC#365  
Set 5/8" x 34" rered with cap  
Wit-(3)3" B. Cherry (CLP) N45W 58.7  
(4)7" Tamarack N85E 79.8  
(5)6" Maple S65E 49.0  
(6)Fd 7/8" solid iron rod S00°29W 56.36

**B. Description of corner evidence found and/or method applied in restoring or reestablishing corner:**

**C-6:** Found 5/8" x 34" rered, bent on top. Set by DNR, midway between Section Corners to North and South, in Centerline of County road. Corner agrees with DNR witnesses. Corner agrees with 1972 retracement survey by J. Meyers P.S.#14099.

See dossier and LCRC#365 for additional information.

**C. Description of monument for corner and accessories established to perpetuate locating the position of the corner:**

**C-6:** Common to Sections 17 & 18. Replaced bent 5/8" rod with 5/8" x 36" rod with Gladwin County Remonumentation cap marked P.S.#27458.


**Witnesses:**

- N67W 3" Oak, nail & tag, 69.80'  
N85E 8" Tamarack, nail & tag, 80.45'  
S65E 7" Maple, nail & tag, 49.87'  
S50E 12" Oak, nail & tag, 91.91'

**APPROVED LAND CORNER**  
P.A. 345 of 1990  
Gladwin County

Co. Rep. [Signature]  
Date 8/11/98

Signed by [Signature]  
Surveyor's Michigan License No. 27458

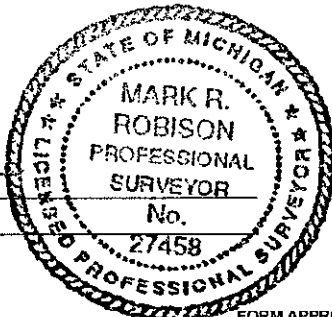

Date 10-5-98