

SURVEY & REMONUMENTATION

OCT 23 1998

GLADWIN County Remonumentation

LAND CORNER RECORDATION CERTIFICATE
Filing Requirement of Act 74, Mich. P.A. 1970

LIBER 001 PAGE 249

SECTION

For corners in

GLADWIN (County)	Located in:	Corner Code #
1. Public Land Survey	T18N R02E	C-7
	T R	
	T R	
	T R	
2. Property Controlling in Section	S T R	
	S T R	
3. Miscellaneous Property in Sec.	S T R	
	S T R	

STATE OF MICHIGAN
GLADWIN COUNTY
FILED-CORNER

13 OCT 1998 12:52:58 PM

BONNIE K. HOUSE
REGISTER OF DEEDS

Register of Deeds Stamp & File Number

4. Lot No. _____, Recorded Plat _____
5. Private Claims _____

I, Mark R Robison, in a field survey on April _____, 1998, do hereby state that under requirements of P.A. 74, Michigan P.A. of 1970, the corner points mention in lines 1 and 2 above were in conformance with regulations and rules therefore as required in the current manual of survey instructions of the United States Department of the Interior, Bureau of Land Management or by a decree of a Court of Law and/or that the corner points mentioned in lines 3, 4 and 5 above were in conformance with the rules of the Michigan Board of Land Surveyors or by a Decree of a Court of Law; established, re-established, monumented, recovered, found as expressed below:

NOTE: Not more than 2 corners, all in the same town and range, may be recorded on this certificate

	A	B	C	D	E	F	G	H	I	J	K	L	M
1													
2	6		5		4		3		2		1		
3													
4	7		8		9		10		11		12		
5													
6	18		17		16		15		14		13		
7													
8	19		20		21		22		23		24		
9													
10	30		29		28		27		26		25		
11													
12	31		32		33		34		35		36		
13													

A. Description of original monument and accessories and/or subsequent restoration:

- C-7:** 1846 John Mullett
Set Post Cor Sec's 17,18,19,20
Wit-(1)Hemlock 10 N38E 29
(2)Do 14 S71W 22
- 1992-97 DNR survey & LCRC#365
Set 5/8" x 34" rerod with cap
Wit-(3)10" Ash N20W 86.9
(4)Top Ctr E End 72" CMP S50E 37.7
(5)Top Ctr W End 72" CMP S60W 42.6
(6)Fd 7/8" Solid Iron rod S6°53'W 8.87

B. Description of corner evidence found and/or method applied in restoring or reestablishing corner:

- C-7:** Found 5/8" x 34" rerod in centerline of county road, set by DNR in large retracement survey of T18N, R2E. Corner agrees with J. Meyers P.S.#14099 1972 retracement survey of this area. Corner agrees with witnesses (3), (4) & (5). Accepted corner in found location. See dossier and LCRC#365 for additional information.

C. Description of monument for corner and accessories established to perpetuate locating the position of the corner:


- C-7:** Corner common to Sections 17, 18, 19 & 20. Accepted 5/8" x 34" rerod (set by DNR). Set Gladwin County Remonumentation cap marked P.S.#27458 on found corner.

Witnesses:
N20W 10" Ash, nail & tag, 85.60'
S50E Top Center East End 72" CMP 37.7'
S60W Top Center West End 72" CMP 42.60'
N30E 14" Ash, nail & tag, 36.80'

APPROVED LAND CORNER
P.A. 845 of 1990
Gladwin County

Co. Rep. J. Meyers
Date 8/11/98

Signed by Mark R Robison
Surveyor's Michigan License No. 27458

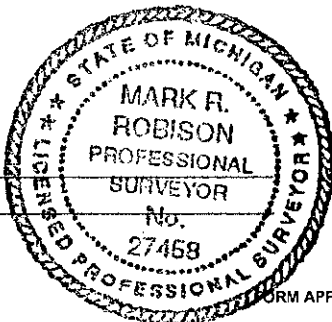

Date 10-5-98