

**SURVEY & REMONUMENTATION**

OCT 23 1998

**SECTION**

GLADWIN County Remonumentation  
**LAND CORNER RECORDATION CERTIFICATE**  
 Filing Requirement of Act 74, Mich. P.A. 1970

LIBER 001 PAGE 250

For corners in

<u>GLADWIN</u> (County)	Located in:	Corner Code #
1. Public Land Survey	T18N R02E	C-8
	T R	
	T R	
	T R	
2. Property Controlling in Section	S T R	
	S T R	
3. Miscellaneous Property in Sec.	S T R	
	S T R	

STATE OF MICHIGAN  
 GLADWIN COUNTY  
 FILED-CORNER  
 13 OCT 1998 12:53:08 PM  
 BONNIE K. HOUSE  
 REGISTER OF DEEDS  
 Register of Deeds Stamp & File Number

4. Lot No. \_\_\_\_\_, Recorded Plat \_\_\_\_\_  
 5. Private Claims \_\_\_\_\_

I, Mark R Robison, in a field survey on April \_\_\_\_\_, 1998, do hereby state that under requirements of P.A. 74, Michigan P.A. of 1970, the corner points mention in lines 1 and 2 above were in conformance with regulations and rules therefore as required in the current manual of survey instructions of the United States Department of the Interior, Bureau of Land Management or by a decree of a Court of Law and/or that the corner points mentioned in lines 3, 4 and 5 above were in conformance with the rules of the Michigan Board of Land Surveyors or by a Decree of a Court of Law; established, re-established, monumented, recovered, found as expressed below:

A	B	C	D	E	F	G	H	I	J	K	L	M
1												
2	6	5		4		3		2		1		
3												
4	7	8		9		10		11		12		
5												
6	18	17		16		15		14		13		
7												
8	19	20		21		22		23		24		
9												
10	30	29		28		27		26		25		
11												
12	31	32		33		34		35		36		
13												

**NOTE: Not more than 2 corners, all in the same town and range, may be recorded on this certificate**

A. Description of original monument and accessories and/or subsequent restoration:  
**C-8:** 1837 Lewis Glason Set 1/4 Post  
 Wit-(1)Maple 22 N19W 10  
 (2)Hem 10 S72W 50

1992-97 DNR survey & LCRC#423  
 Replaced R/R spike with capped 5/8" x 34" rerod  
 Wit-(3)6" W. Pine N40W 119.12  
 (4)6" W. Pine N70E 129.51  
 (5)4" W. Pine S25W 96.52  
 (6)4" W. Pine S45W 83.93

1972 Lapham working dwg  
 Set Cor centerline of unimproved county road opposite fence to East R/R spike by J. Meyers, P.S.#14099  
 Wit-none


B. Description of corner evidence found and/or method applied in restoring or reestablishing corner:  
**C-8:** Found 5/8" x 34" capped iron in centerline of county road opposite remains of old fence to East. Part of large retracement survey by J. Meyers, P.S.#14099 and DNR. Accepted corner and witnesses as in place. Corner agrees with (3), (4) & (6).  
 See dossier for detailed report.

C. Description of monument for corner and accessories established to perpetuate locating the position of the corner:  
**C-8:** Corner common to Sections 19 & 20. Set Gladwin County Remonumentation cap marked P.S.#27458 on DNR 5/8" x 34" rerod.

Witnesses:  
 N40W 6" W. Pine, spike, 119.12'  
 N70E 6" W. Pine, spike, 129.51'  
 S45W 4" W. Pine, spike, 83.93'  
 S80W 18" W. Pine, nail & tag, 116.75'

**APPROVED LAND CORNER**  
 P.A. 345 of 1990  
 Gladwin County

Co. Rep. [Signature]  
 Date 5/14/98

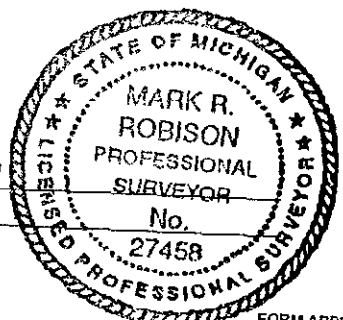

Signed by [Signature]  
 Surveyor's Michigan License No. 27458

Date 10-5-98