LAND CORNER RECORDATION CERTIFICATE

Filing Requirement of Act 74, Mich. P.A. 1970

For corners in GLADWIN (County)

	Located In:	Corner Code ##
1. Public Land Survey	T 19N R 2E	E-1, F-1,
	T ___ R ___	G-1, H-1
	T ___ R ___	
	T ___ R ___	
2. Property Controlling	S ___ T ___ R ___	
in Section	S ___ T ___ R ___	
3. Miscellaneous	S ___ T ___ R ___	
Property in Sec.	S ___ T ___ R ___	

Register of Deeds Stamp & File Number

4. Lot No. _____ , Recorded Plat _____
5. Private Claims _____

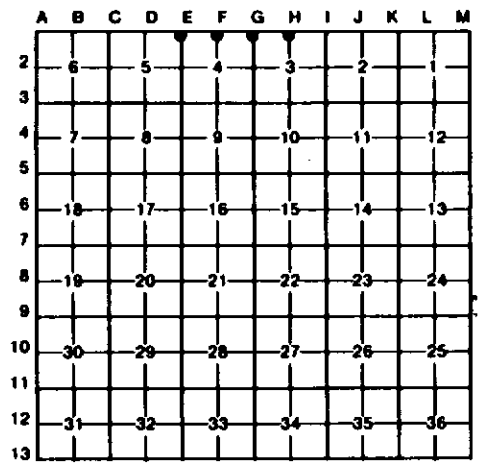

I, C.T. KIISKILA, in a field survey on NOVEMBER 28, 19 94, do hereby certify that under requirements of P.A. 74, Michigan P.A. of 1970, the corner points mentioned in lines 1 and 2 above were in conformance with regulations and rules therefore as required in the current manual of survey instructions of the United States Department of the Interior, Bureau of Land Management or by a decree of a Court of Law and/or that the corner points mentioned in lines 3, 4 and 5 above were in conformance with the rules of the Michigan Board of Land Surveyors or by a Decree of a Court of Law; established, re-established, monumented, re-monumented, recovered, found as expressed below:

NOTE: Not more than 4 corners, all in the same town and range, may be recorded on this certificate.

A. Description of original monument and accessories and/or subsequent restoration:

G-1 E-1 F-1 H-1

(NO CONCLUSIVE EVIDENCE OF G.L.O. CORNER MONUMENT, CORNER BT'S, LINE TREES, TOPOGRAPHY, ETC. AS CALLED OUT IN THE G.L.O. LINE NOTES; UNLESS NOTED IN ITEM "B" BELOW.)

STATE OF MICHIGAN
CARL KIISKILA
LAND SURVEYOR
No. 33981
LICENSED LAND SURVEYOR

B. Description of corner evidence found and/or method applied in restoring or reestablishing corner:

G-1
ACCEPTED OLD RUSTY 1 1/2" PIPE FOR NW COR S-3.

E-1
RESET NE COR OF SEC 5 PER 1984 DEPT SURVEY DATA. (CORNER WAS DESTROYED DURING TIMBER HARVEST - CLEARCUT.) N-S WINDING TRAIL IS 1318'± W. WINDING TRAIL N'LY & SE'LY IS 727'± EAST.

F-1
ACCEPTED 1 1/2" PIPE FOR N 1/4 COR SEC 4. CORNER PROBABLY SET BY M. SCHAAF, CONSERVATION DEPT. FORESTER/SURVEYOR IN 1930'S.

H-1
REESTABLISHED N 1/4 SEC 3 EQUIDISTANT BETWEEN FD NW COR & FD NE COR SEC 3 AND ON LINE BETWEEN FD SE COR AND SW COR SEC 34, T19N-R2E. CTR SAND RD (LOOKING W) IS 3'± EAST. CENTER SAND ROAD (LOOKING E) IS 7'(± 3') SOUTH.

C. Description of monument for corner and accessories established to perpetuate locating the position of the corner:

G-1
REPL'D FD OLD 1 1/2" X 43" PIPE W/DNR MON & SET CED POST.

8" TW MAPLE	N20°W	15.0'
3" B CHERRY	S85°E	28.3'
7" MAPLE	S10°W	16.1'
3" B CHERRY	S50°W	11.1'

DNR MON, SE COR. S-33, T19N-R2E N89°59'E 7.30'

E-1
SET DNR MON & CED POST.

DNR MON SW COR SEC 33 T19N-R2E S89°56'E 8.00'

NO WITS AVAILABLE- CLEARCUT AREA.

F-1
FD OLD 1 1/2" PIPE. DROVE 1" X 84" GALV PIPE W/ALUM DNR CAP. SET CED POST.

12" ASH	N85°W	76.2'
6" MAPLE	N10°E	38.6'
8" MAPLE	N40°E	55.6

DNR MON S1/4 COR S-33 T19N-R2E N89°59'E 7.54'

H-1
DROVE 5/8" X 34" REROD W/RLS CAP.

8" MAPLE (CLP3)	N40°W	26.8'
14" MAPLE	N40°E	52.3'
2" MAPLE CLUMP	S30°E	35.5'
10" MAPLE	S85°W	16.2'
SET CED POST W/LOC TAG.	SOUTH	33'

5/8" REROD, S1/4 S-34, T19N-R2E N89°57'E 3.65

Signed by Carl T Kiiskila Date 3-28-97

Surveyor's Michigan License No. 33981

FORM APPROVED BY MICHIGAN STATE BOARD OF LAND SURVEYORS, JAN. 28, 1971
REVISED MAY 14, 1975
REVISED JAN., 1983