# LAND CORNER RECORDATION CERTIFICATE

**Filing Requirement of Act 74, Mich. P.A. 1970**

For corners in BLANKIN (County)

| | Located In: | Corner Code ## |
|---|---|---|
| 1. Public Land Survey | T 18N R 2E | E-5, F-5, |
| | T ___ R ___ | |
| | T ___ R ___ | |
| | T ___ R ___ | |
| 2. Property Controlling | S 16 T ___ R ___ | 1, 2 |
| in Section | S ___ T ___ R ___ | |
| 3. Miscellaneous | S ___ T ___ R ___ | |
| Property in Sec. | S ___ T ___ R ___ | |

**Register of Deeds Stamp & File Number**

4. Lot No. _____ , Recorded Plat _____
5. Private Claims _____

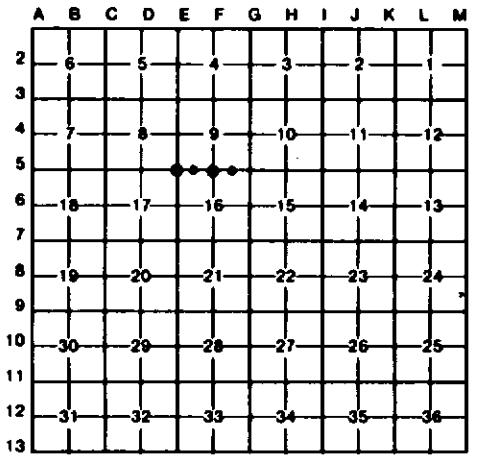


I, C.T. KIISKILA, in a field survey on JULY 19, 19 94, do hereby certify that under requirements of P.A. 74, Michigan P.A. of 1970, the corner points mentioned in lines 1 and 2 above were in conformance with regulations and rules therefore as required in the current manual of survey instructions of the United States Department of the Interior, Bureau of Land Management or by a decree of a Court of Law and/or that the corner points mentioned in lines 3, 4 and 5 above were in conformance with the rules of the Michigan Board of Land Surveyors or by a Decree of a Court of Law; established, re-established, monumented, re-monumented, recovered, found as expressed below:

**NOTE: Not more than 4 corners, all in the same town and range, may be recorded on this certificate.**

A. Description of original monument and accessories and/or subsequent restoration:

| E-5 | F-5 | 1 | 2 |
|---|---|---|---|
| (NO CONCLUSIVE EVIDENCE OF G.L.O. CORNER MONUMENT, CORNER BT'S, LINE TREES, TOPOGRAPHY, ETC. AS CALLED OUT IN THE G.L.O. LINE NOTES; UNLESS NOTED IN ITEM "B" BELOW.) | | | |

STATE OF MICHIGAN
CARL KIISKILA
LAND SURVEYOR
No. 33981
LICENSED LAND SURVEYOR

B. Description of corner evidence found and/or method applied in restoring or reestablishing corner:

| E-5 | F-5 | 1 | 2 |
|---|---|---|---|
| REESTAB'D SW COR S-9 RECORD DIST'S SOUTH OF FD W 1/4 S-9 & WEST OF REESTAB'D S 1/4 S-9 PER P.S. J.MEYERS RETRACEMENT SURVEY DATA IN THIS AREA. THIS ALSO FITS J.MEYERS CERT OF SURVEYS IN NW 1/4 OF S-16. COR FITS REASONABLE TO TWO US STREAM TIES TO SOUTH: U.S. MEAS 574' & 1188' SOUTH; WE MEAS 541' & 1173' SOUTH OF COR TO S EDGE OF STREAMS. | REESTAB'D S 1/4 COR OF S-9 PER P.S. J.MEYERS SURVEY DATA IN S-9. | ACCEPTED J.MEYERS IRON FOR NE CORNER OF NW 1/4 OF NW 1/4 OF SEC 16 (COR SET IN 1978 SURVEY FOR NE 1/4 OF NW 1/4 BY J.M.) IRON IS AT FN CORNER, SINGLE WIRE (DOWN) N-S-E AND AT EDGE OF SWAMP. | ACCEPTED P.S. J. MEYERS IRON FOR NW COR OF NE 1/4 OF NE 1/4 OF S-16. CTR OF 2' - 3' WIDE DRAINAGE DITCH, COURSE N'LY FROM SE, IS 26'± EAST. |

C. Description of monument for corner and accessories established to perpetuate locating the position of the corner:

| E-5 | | | F-5 | | | 1 | | | 2 | | |
|---|---|---|---|---|---|---|---|---|---|---|---|
| SET BNR MON & CED POST. | | | SET BNR MON & CED POST. | | | FD CAPPED REROD #14099. | | | FD 1/2" REROD W/RLS CAP. | | |
| | | | 12" OAK | S82°E | 25.1' | | | | ADDED 5/8" X 34" REROD W/RLS | | |
| 8" MAPLE | S09°W | 29.7' | *20" OAK | S30°W | 35.8' | 6" MAPLE | N56°E | 31.2' | CAP & SET CED POST W/LOC TAG. | | |
| 2" OAK | S26°E | 10.11' | 6" OAK | N59°W | 8.7' | 14" OAK | S81°E | 28.0' | 7" MAPLE | S35°E | 9.8' |
| 2" MAPLE | N51°E | 18.7' | 4" OAK | N23°E | 32.2' | 12" MAPLE | S83°W | 13.2' | 3" MAPLE | S40°W | 13.5' |
| 2" OAK | N22°W | 14.3' | SET CED POST | EAST | 1.5' | 10" TW MAPLE | N42°W | 29.0' | 5" MAPLE | N75°W | 20.4' |
| | | | CAPPED IRON | | | SET CED POST | SOUTH | 1' | 7" MAPLE | N50°W | 21.4' |
| | | | #14099 | N42°W | 1.15' | | | | | | |
| | | | *=OLD WITNESS TREE DIFFERENT DISTANCE. | | | | | | | | |

Signed by Carl T. Kiiskila Date 3-28-97

Surveyor's Michigan License No. 33981

FORM APPROVED BY MICHIGAN STATE BOARD OF LAND SURVEYORS, JAN. 26, 1971
REVISED MAY 14, 1975
REVISED JAN., 1983