LAND CORNER RECORDATION CERTIFICATE

Filing Requirement of Act 74, Mich. P.A. 1970

For corners in
GLADWIN
(County)

Located In:

Corner Code #

1. Public Land Survey		T 18N	R2E	E-9, F-9
		T ____	R ____	G-9
		T ____	R ____	
		T ____	R ____	
2. Property Controlling	S 29	T ____	R ____	2
In Section	S ____	T ____	R ____	
3. Miscellaneous	S ____	T ____	R ____	
Property in Section	S ____	T ____	R ____	

Register of Deeds Stamp & File Number

4. Lot No. _____, Recorded Plat _____
5. Private Claims _____

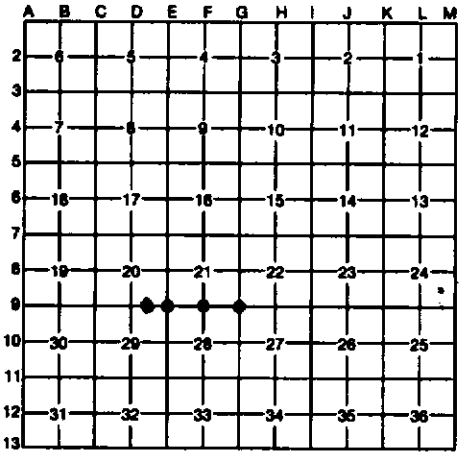

I, C.T. KIISKILA, in a field survey on JULY 28, 19 94, do hereby certify that under requirements of P.A. 74, Michigan P.A. of 1970, the corner points mentioned in lines 1 and 2 above were in conformance with regulations and rules therefore as required in the current manual of survey instructions of the United States Department of the Interior, Bureau of Land Management or by a decree of a Court of Law and/or that the corner points mentioned in lines 3, 4 and 5 above were in conformance with the rules of the Michigan Board of Professional Surveyors or by a Decree of a Court of Law; established, re-established, monumented, re-monumented, recovered, found as expressed below:

NOTE: Not more than 4 corners, all in the same town and range, may be recorded on this certificate.

A. Description of original monument and accessories and/or subsequent restoration:

E-9

(NO CONCLUSIVE EVIDENCE OF G.L.O. CORNER MONUMENT, CORNER BT'S, LINE TREES, TOPOGRAPHY, ETC. AS CALLED OUT IN THE G.L.O. LINE NOTES; UNLESS NOTED IN ITEM "B" BELOW.)

F-9

G-9

2

STATE OF MICHIGAN
CARL KIISKILA
LAND SURVEYOR
No. 33981
LICENSED LAND SURVEYOR

B. Description of corner evidence found and/or method applied in restoring or reestablishing corner:

E-9

REESTABLISHED SW COR OF SEC 21 AT BEST AVERAGE OF CTR OF GRAVEL/SAND RDS E-W-S AND TRAIL N AND TO FIT P.S. J.MEYERS SURVEY INFO TO N & E. AFTER MON WAS SET, WE COULD NOT GET MAGNETIC PULL ON IT SO WE ADDED 3/4"X 15" SOLID IR ROD UNDER DNR CAP & ALONGSIDE PIPE. WE MEAS. 525'± S. TO SOUTH EDGE OF STREAM THRU CULVERT; U.S. MEAS. 514.8'

F-9

REESTABLISHED S 1/4 COR SEC 21 MIDWAY & ON LINE BETWEEN SE & SW CORS OF SEC 21. COR FALLS IN CTR OF E-W GRAVEL RD & AT WEST TOE OF SMALL HILL IN LOW AREA.

G-9

REESTABLISHED SW COR SEC 22 IN AVERAGE CENTER OF E-W GRAVEL RD AND PRORATED DIST 1 MILE E & W TO P.S. J.MEYERS SURVEY DATA.

2

ESTABLISHED NE COR NW 1/4 OF THE NE1/4 OF SEC 29 PER STANDARD BLM INSTRUCTIONS. CTR 23' ± WIDE E-W GRAVEL ROAD IS 4' SOUTH.

C. Description of monument for corner and accessories established to perpetuate locating the position of the corner:

E-9

SET DNR MON 12" DEEP.

6" TW W PINE	S74°W	71.43'
8" W PINE	N67°E	51.23'
24" B CHERRY	S38°E	106.29'
SET CED POST	N34°W	28.81'
CTR E-W GRVL RD	SOUTH	6'

F-9

SET DNR MON.

3" MAPLE CLUMP	S50°W	40.62'
2" MAPLE CLUMP	S33°E	42.75'
3" POPLAR	N60°W	59.31'
SET CED POST	NORTH	33.22'

G-9

SET DNR MON 12" DEEP.

10" OAK	S50°E	30.79'
6" OAK	S58°W	22.82'
16" OAK	N34°W	47.74'
10" J. PINE	N56°E	80.74'
SET CED POST WITH LOC. TAG	NORTH	33'
CTR LINE GRIM RD	NORTH	4'

2

DROVE 5/8" X 34" REROD W/PS CAP.

7" ELM	N05°E	15.92'
12" MAPLE	S10°E	45.76'
8" MAPLE	S15°W	69.73'
9" ASH	S50°W	74.02'
SET CED POST W/ LOC TAG	SOUTH	33'

Signed by Carl T Kiiskila Date 3-28-97

Surveyor's Michigan License No. 33981

FORM APPROVED BY MICHIGAN STATE BOARD OF PROFESSIONAL SURVEYORS, JAN. 28, 1971
REVISED MAY 14, 1975
REVISED JAN., 1983