

LAND CORNER RECORDATION CERTIFICATE
Filing Requirement of Act 74, Mich. P.A. 1970

For corners in
GLADWIN
 (County)

Located In: _____ Corner Code ~~≠~~ _____

1. Public Land Survey	T <u>18N</u> R <u>2E</u>	<u>H-9, I-8,</u>
	T _____ R _____	<u>I-9</u>
	T _____ R _____	_____
	T _____ R _____	_____
2. Property Controlling in Section	S <u>22</u> T _____ R _____	<u>7</u>
	S _____ T _____ R _____	_____
3. Miscellaneous Property in Sec.	S _____ T _____ R _____	_____
	S _____ T _____ R _____	_____

Register of Deeds Stamp & File Number

4. Lot No. _____, Recorded Plat _____
 5. Private Claims _____


	A	B	C	D	E	F	G	H	I	J	K	L	M
2	6	5	4	3	2	1							
3													
4	7	8	9	10	11	12							
5													
6	18	17	16	15	14	13							
7													
8	19	20	21	22	23	24							
9													
10	30	29	28	27	26	25							
11													
12	31	32	33	34	35	36							
13													

I, C.T. KIISKILA, in a field survey on JULY 19, 19 94, do hereby certify that under requirements of P.A. 74, Michigan P.A. of 1970, the corner points mentioned in lines 1 and 2 above were in conformance with regulations and rules therefore as required in the current manual of survey instructions of the United States Department of the Interior, Bureau of Land Management or by a decree of a Court of Law and/or that the corner points mentioned in lines 3, 4 and 5 above were in conformance with the rules of the Michigan Board of Land Surveyors or by a Decree of a Court of Law; established, re-established, monumented, re-monumented, recovered, found as expressed below.

NOTE: Not more than 4 corners, all in the same town and range, may be recorded on this certificate.

A. Description of original monument and accessories and/or subsequent restoration:
 H-9 I-8 I-9

(NO CONCLUSIVE EVIDENCE OF G.L.O. CORNER MONUMENT, CORNER BT'S, LINE TREES, TOPOGRAPHY, ETC. AS CALLED OUT IN THE G.L.O. LINE NOTES; UNLESS NOTED IN ITEM "B" BELOW.)

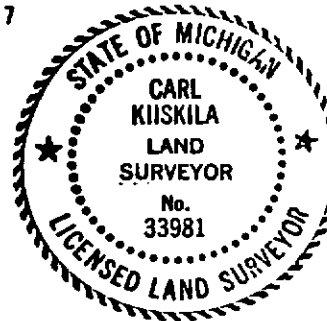

B. Description of corner evidence found and/or method applied in restoring or reestablishing corner:

H-9	I-8	I-9	7
REESTABLISHED S 1/4 COR SEC 22 MIDWAY AND ON LINE BETH FD SE COR SEC 22 & REESTABLISHED SW COR SEC 22.	REESTABLISHED E 1/4 COR SEC 22 MIDWAY & ON LINE BETWEEN FD NE & SE COR'S OF SEC 22. COR FALLS AT W EDGE OF N-S GRAVEL RD & 16' SOUTH OF WINDING TRAIL RD TO WEST.	ACCEPTED FD 1/2" REROD FOR SE COR SEC 22 AS SET BY P.S. P.LAPHAM IN 1977. (FITS 2 FD P.LAPHAM WITS.) COR IS IN INTERSEC OF GRAVEL RDS E-W-N.	ACCEPTED FD 1/2" REROD BY J. MEYERS FOR NE COR OF SE 1/4 OF NE 1/4 OF SEC 22. J.MEYERS SET CORNER IN 1976 SURVEY FOR THE NE 1/4 OF NE 1/4 OF SEC 22. CTR OF N-S GRAVEL RD IS 4' EAST. FD 1/2" ROD W/L.U. PS CAP #14469 WEST 33.21', FLUSH WITH GROUND. (FD 1/2" REROD ON EAST SIDE OF L.U. CAPPED IRON, STICKING UP 2" ±.)

C. Description of monument for corner and accessories established to perpetuate locating the position of the corner:

H-9	I-8	I-9	7
SET DNR NON 1' BELOW GROUND.	SET DNR NON 1.0' DEEP.	FD 1/2" REROD IN CTR INTERSEC OF GRIN RD & CTR FIRE LINE RD (0.8' DEEP).	FD 1/2" REROD BENT. REPL'D W/ 5/8" X 3/4" REROD, 0.7' DEEP.
12" TN OAK N36°W 83.78'	14" OAK S10°W 29.52'		14" J PINE S22°W 59.72'
16" OAK N18°E 44.53'	8" OAK S80°E 41.98'		18" OAK N60°W 49.21'
19" OAK N64°E 71.50'	16" OAK N47°E 50.88'	5" OAK N52°E 55.83'	8" J PINE N18°W 44.21'
CTR E-W GRIN RD NORTH 4'	12" OAK N03°W 48.31'	8" OAK S05°E 31.33'	FD 7/8" REROD WEST 36.03'
SET CED POST W/ LOC TAG NORTH 39.68'	CTR N-S GRVL RD EAST 14'	10" TRPL OAK N43°W 79.46'	SET CED POST WEST 33'
	SET CED POST N80°W 10'	4" J PINE S62°W 39.40'	
		CTR E-W GRIN RD SOUTH 1'	

Signed by Carl T. Kiiskila Date 3-28-97
 Surveyor's Michigan License No. 33981