

LAND CORNER RECORDATION CERTIFICATE
Filing Requirement of Act 74, Mich. P.A. 1970

For corners in
GLADWIN

(County)

Located In:

Corner Code \neq

1. Public Land Survey	T <u>18N</u>	R <u>2E</u>	<u>E-10, E-11</u>
	T _____	R _____	<u>E-12</u>
	T _____	R _____	_____
	T _____	R _____	_____
2. Property Controlling In Section	S <u>29</u>	T _____	<u>7</u>
	S _____	T _____	_____
3. Miscellaneous Property in Sec.	S _____	T _____	_____
	S _____	T _____	_____

Register of Deeds Stamp & File Number

4. Lot No. _____, Recorded Plat _____
 5. Private Claims _____


I, C. T. KIISKILA, in a field survey on MAY 10, 19 95, do hereby certify that under requirements of P.A. 74, Michigan P.A. of 1970, the corner points mentioned in lines 1 and 2 above were in conformance with regulations and rules therefore as required in the current manual of survey instructions of the United States Department of the Interior, Bureau of Land Management or by a decree of a Court of Law and/or that the corner points mentioned in lines 3, 4 and 5 above were in conformance with the rules of the Michigan Board of Land Surveyors or by a Decree of a Court of Law; established, re-established, monumented, re-monumented, recovered, found as expressed below:

NOTE: Not more than 4 corners, all in the same town and range, may be recorded on this certificate.

A. Description of original monument and accessories and/or subsequent restoration:

(NO CONCLUSIVE EVIDENCE OF G.L.O. CORNER MONUMENT, CORNER BT'S, LINE TREES, TOPOGRAPHY, ETC. AS CALLED OUT IN THE G.L.O. LINE NOTES; UNLESS NOTED IN ITEM "B" BELOW.)

A	B	C	D	E	F	G	H	I	J	K	L	M
2	6	5	4	3	2	1						
3												
4	7	8	9	10	11	12						
5												
6	18	17	16	15	14	13						
7												
8	19	20	21	22	23	24						
9												
10	30	29	28	27	26	25						
11												
12	31	32	33	34	35	36						
13												

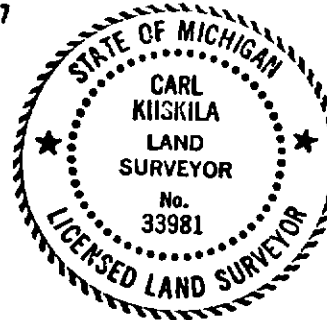

B. Description of corner evidence found and/or method applied in restoring or reestablishing corner:

E-10 REESTABLISHED E 1/4 COR SEC 29 NIDWAY & ON LINE BETWEEN FB SE COR SEC 29 & REESTABLISHED NE COR SEC 29. CENTER OF 17' WIDE N-S SAND RD IS 4' EAST. THIS FITS U.S. STREAM TIE TO NORTH. U.S. MEAS 2125' TO SOUTH EDGE 17'± WIDE STREAM. NE MEAS 2130' TO CTR OF 3-48" DIA CULVERTS ACROSS ROAD.	E-11 ACCEPTED FB 3/8" REROD FOR SE COR. SEC. 29. CORNER IS IN LINE W/CTR. OF N-S SAND ROAD AND FITS U.S. G.L.O. DIST'S. ONE MILE TO NORTH AND SOUTH. CENTER OF OLD E-W ROAD GRADE (CYCLE TRAIL NOW) IS 40'± NORTH.	E-12 REESTABLISHED THE E1/4 COR. OF SEC. 32 NIDWAY AND ON LINE BETWEEN FB. SEC. COR'S. 1/2 MILE TO NORTH AND SOUTH. CORNER FALLS IN CTR. OF N-S SAND/DIRT ROAD, IN LOW NET AREA.	7 ESTABLISHED THE NE COR OF SE 1/4 OF NE 1/4 OF S-29 PER STANDARD BLM INSTRUCTIONS. CTR OF N-S SAND ROAD IS 2' EAST.
--	---	--	--

C. Description of monument for corner and accessories established to perpetuate locating the position of the corner:

E-10 DROVE 5/8" X 34" REROD W/PS CAP. 4" MAPLE N60°W 30.27' 6" TRPL MAPLE N40°E 50.84' 6" ASH S75°E 59.17' 7" ASH S40°W 26.39' SET CED POST W/ LOC TAG. WEST 32.78'	E-11 REPLACED FB 3/8" REROD WITH 5/8" X 34" REROD W/PS CAP. 12" TW MAPLE N70°W 30.57' 10" MAPLE S60°E 34.07' 8" MAPLE S40°W 33.05' 21" W OAK N65°E 46.09' SET CED POST W/ LOC TAG. WEST 32.52'	E-12 DROVE 5/8" X 34" REROD W/PS CAP. 16" ASH N45°W 41.45' 10" MAPLE N30°E 51.57' 2" MAPLE N70°E 28.74' 6" ASH S45°E 26.92' SET CED POST W/ LOC TAG. WEST 33'	7 DROVE 5/8" X 34" REROD W/PS CAP. 14" MAPLE N65°W 45.41' 5" B OAK S40°E 57.01' 15" B OAK S55°W 54.73' SET CED POST W/ LOC TAG. WEST 32.99' 18" CMP X-CULV W/2'± WIDE STREAM NORTH 58'
--	---	--	--

Signed by Carl T. Kiiskila

Date 3-28-97

Surveyor's Michigan License No. 33981