

**LAND CORNER RECORDATION CERTIFICATE**  
**Filing Requirement of Act 74, Mich. P.A. 1970**

For corners in  
**GLADWIN**

(County)	Located In:	Corner Code <del>≠</del>
1. Public Land Survey	T 18N R 2E	A-5, A-6, A-7
	T _____ R _____	_____
	T _____ R _____	_____
	T _____ R _____	_____
2. Property Controlling in Section	S 18 T _____ R _____	1
	S _____ T _____ R _____	_____
3. Miscellaneous Property in Sec.	S _____ T _____ R _____	_____
	S _____ T _____ R _____	_____

Register of Deeds Stamp & File Number

4. Lot No. \_\_\_\_\_, Recorded Plat \_\_\_\_\_  
 5. Private Claims \_\_\_\_\_


	A	B	C	D	E	F	G	H	I	J	K	L	M
2	6		5		4		3		2		1		
3													
4	7		8		9		10		11		12		
5													
6	18		17		16		15		14		13		
7													
8	19		20		21		22		23		24		
9													
10	30		29		28		27		26		25		
11													
12	31		32		33		34		35		36		
13													

I, C.F. ROSE in a field survey on SEPT. 15, 19 94  
do hereby certify that under requirements of P.A. 74, Michigan P.A. of 1970, the corner points mentioned in lines 1 and 2 above were in conformance with regulations and rules therefore as required in the current manual of survey instructions of the United States Department of the Interior, Bureau of Land Management or by a decree of a Court of Law and/or that the corner points mentioned in lines 3, 4 and 5 above were in conformance with the rules of the Michigan Board of Land Surveyors or by a Decree of a Court of Law; established, re-established, monumented, re-monumented, recovered, found as expressed below:

**NOTE:** Not more than 4 corners, all in the same town and range, may be recorded on this certificate.

A. Description of original monument and accessories and/or subsequent restoration

(NO EVIDENCE OF G.L.O. CORNER, B.T.'S, LINE TREES & TOPOGRAPHY, AS CALLED OUT IN THE G.L.O. LINE NOTES; UNLESS NOTED IN ITEM "B" BELOW.)

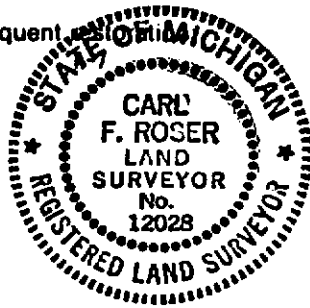

(B. CONT.) -- (1-SMOOTH WIRE ON SCATTERED STEEL FN POSTS, WEST AND CED. POSTS W/B-W N-S-E) IS 35'± N & 13'± E. ALSO SEE CORNER B-5, 1/4 CORNER TO SEC'S 7 & 18.

B. Description of corner evidence found and/or method applied in restoring or reestablishing corner:

A-5	A-6	A-7	1
ACCEPTED FD 1/2" REROD FOR NW COR SEC 18; AS SET BY PS, J. MEYERS, 1982. COR FITS NH CONSULTING SERVICES 1992 CERTIFICATE OF SURVEY (NOT RECORDED). COR IN CTR SAND TRAIL TO S. CTR 22'± WIDE E-W SAND RD IS 4' N.	REESTABLISHED W1/4 COR SEC 18 M.O.L. B'TWN NW & SW SEC COR'S. COR FALLS ON NE SLOPE OF RAVINE AS GLO NOTED. COR FITS GLO BROOK TIE 4 1/2 CHS (297') S; NE MEA. 310'± 6'. A 1'-2' WIDE BROOK, WINDING SE'LY, IS 195'± 5' N (NOT TIED IN GLO). DID NOT FIND OLD 3/4" PIPE AS NOTED ON M.H. CONSULTING SERVICE 1992 CERTIFICATE OF SURVEY.	ACCEPTED FD 1/2" REROD; DROVE 1"x 60" GALV. PIPE W/ALUM. DNR CAP FOR SW COR SEC 18. FITS PS, H.FLUHARTY 1978 COR OF RECORD. FLUHARTY SAID, "FD 1/2" REBAR W/RLS CAP JS #18664". E'LY EDGE OF MOLASSES RV. IS 51'± 2' W.	ESTABLISHED W1/8 COR ON N. LINE OF SEC 18 (NE COR OF FRL NW 1/4 OF FRL NW 1/4 OF S-18), ON LINE BETWEEN THE NW AND N 1/4 OF S-18 AND AT PROP MEAS. TO G.L.O. (U.S.) SURVEY (RUN OUT SECTION), COR FALLS 5'± SOUTH OF CTR OF E-W 10'± WD SAND RD. A FENCE CORNER (CED. POSTS W/B-W N-S-E) IS 22'± SOUTH AND 10'± EAST. ALSO, A FN COR -- CONT. ABOVE --

C. Description of monument for corner and accessories established to perpetuate locating the position of the corner:

A-5	A-6	A-7	1
FD 1/2" REROD. #16" W.PINE N60°W 47.67' #38" W.PINE N25°E 85.62' #9" MAPLE S55°E 52.20' #12" TW.MAPLE S50°W 37.33'	SET DNR MON AND CEDAR POST. 8" MAPLE N54°W 16.4' 9" CEDAR N05°E 28.5' 11" TAMARACK N15°E 32.2' 13" SUB.MAPLE N05°E 13.2' 4" R.OAK S30°E 2.0'	FD 1/2" REROD. DROVE 1"x 60" PIPE W/ALUM. DNR CAP. SET CEDAR POST. #14" MAPLE N60°W 34.4' #12" TW.CEDAR STP N60°E 32.67' 19" W.PINE N70°E 52.6' #12" CEDAR S35°W 32.8' FD 1/2" I.D. PIPE N55°21'E 36.35' #RLS HERB FLUHARTY, 1978 WIT.	DROVE 5/8"x 3/4" REROD W/PS CAP 8" R.OAK S10°E 23.8' 10" R.OAK S10°W 11.9' 2" PIPE (N'LY GATE POST) N50°E 15.8' DROVE 5/8"x 3/4" REROD'S W/PS CAPS & SET CEDAR POSTS N00°35'W 33.00' AND S00°09'E 33.00' (LOC. TAG PUT ON S'LY POST)

±= WIT'S BY OTHER'S.

Signed by Carl F. Roser

Date 12-14-94

Surveyor's Michigan License No. 12028