


**LAND CORNER RECORDATION CERTIFICATE**  
**Filing Requirement of Act 74, Mich. P.A. 1970**

For corners in  
GLADWIN  
 (County)

Located In: \_\_\_\_\_ Corner Code #/

- |                                    |   |     |   |    |          |
|------------------------------------|---|-----|---|----|----------|
| 1. Public Land Survey              | T | 18N | R | 2E | C-2, C-3 |
|                                    | T |     | R |    |          |
|                                    | T |     | R |    |          |
|                                    | T |     | R |    |          |
| 2. Property Controlling in Section | S |     | T | R  |          |
|                                    | S |     | T | R  |          |
| 3. Miscellaneous Property in Sec.  | S |     | T | R  |          |
|                                    | S |     | T | R  |          |
4. Lot No. \_\_\_\_\_, Recorded Plat \_\_\_\_\_
5. Private Claims \_\_\_\_\_

Register of Deeds Stamp & File Number

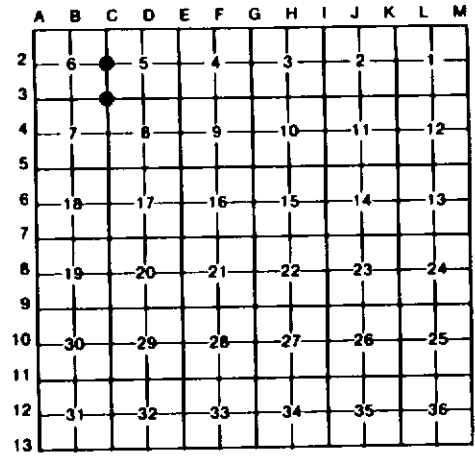

I, CARL T. KIISKILA, in a field survey on NOVEMBER 11, 19 94, do hereby certify that under requirements of P.A. 74, Michigan P.A. of 1970, the corner points mentioned in lines 1 and 2 above were in conformance with regulations and rules therefore as required in the current manual of survey instructions of the United States Department of the Interior, Bureau of Land Management or by a decree of a Court of Law and/or that the corner points mentioned in lines 3, 4 and 5 above were in conformance with the rules of the Michigan Board of Land Surveyors or by a Decree of a Court of Law; established, re-established, monumented, re-monumented, recovered, found as expressed below:

**NOTE: Not more than 4 corners, all in the same town and range, may be recorded on this certificate.**

**A. Description of original monument and accessories and/or subsequent restoration:**

**C-2**  
 U.S. G.L.O. - SET OR SECTION POST; HEMLOCK 10 S71°W 34, HEMLOCK 6 N65°E 14. NO SIGN OF GOVT. POST OR WIT.

**C-3**  
 U.S. G.L.O. - SET POST CORNER SECTIONS 5,6,7,8; W.PINE 12 N60°W 05, W.PINE 12 S60°E 29. NO SIGN OF GOVT. POST OR WIT'S.

**B. Description of corner evidence found and/or method applied in restoring or reestablishing corner:**

**C-2**  
 RECOVERED 1 1/4" PIPE IN IRREGULAR 6"x 6" CONC. BLOCK MON (BURIED 13") IN OLD N-S RD GRADE; FOR W1/4 COR SEC. 5. COR IS WITHIN 3' FOR POSITION OF CALC PROPORTIONATE MEASURE TO GLO, RUN OUT MILE. CORNER FITS FOUND BOTH RLS, M.SCHAAF (RLS-FORESTRY CHIEF FOR MICH. DEPT. OF CONSERVATION) 1930'S +/- WIT PITS.


**C-3**  
 RECOVERED 2" O.D. SHORT PIPE IN 6"x 6" IRREGULAR CONC. BLOCK FOR NW COR 5-8. MON. WAS SET PER SURVEY BY R.L.S. M.SCHAAF IN 1930'S +/-; RLS- FORESTRY CHIEF FOR MICH. DEPT OF CONSERVATION. CORNER FITS FOUND STPS OF 3 PS, J.MEYERS WITS.

**C. Description of monument for corner and accessories established to perpetuate locating the position of the corner:**

**C-2**  
 FD 1 1/4" SHORT PIPE IN 6"x 6" CONC. BLOCK; ADDED 5/8"x 18" REROD W/PS CAP.  
 2" MAPLE N60°W 22.6'  
 2" OAK N40°W 41.3'  
 3" OAK N35°E 51.9'  
 3" ASPEN S70°E 26.3'  
 SET CEDAR POST W/LOC TAG EAST 16.2'

**C-3**  
 FD 6"x 6"x 6" CONC. BLOCK W/2" DD SHORT PIPE; RAISED WITH 1 1/4" DIAMETER x 21" SOLID IRON.  
 2" OAK N20W 40.5'  
 #36" OAK STP S50°E 46.2'  
 2" MAPLE (CLUMP) S50°W 19.9'  
 2" MAPLE (CLUMP) S85°W 39.4'  
 SET CEDAR POST W/LOC TAG EAST 33.00'

‡ = PS, J.MEYERS WIT.

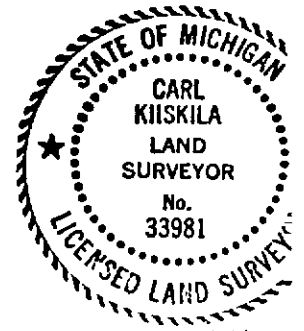

Signed by Carl T. Kiiskila Date 4-7-97  
 Surveyor's Michigan License No. 33981