

**LAND CORNER RECORDATION CERTIFICATE**  
**Filing Requirement of Act 74, Mich. P.A. 1970**

For corners in  
**GLADWIN**  
 (County)

Located In:

Corner Code **#**

- |                                       |   |     |   |    |     |
|---------------------------------------|---|-----|---|----|-----|
| 1. Public Land Survey                 | T | 18N | R | 2E | A-3 |
|                                       | T |     | R |    |     |
|                                       | T |     | R |    |     |
|                                       | T |     | R |    |     |
| 2. Property Controlling in Section    | S |     | T | R  |     |
|                                       | S |     | T | R  |     |
| 3. Miscellaneous Property in Sec.     | S |     | T | R  |     |
|                                       | S |     | T | R  |     |
| 4. Lot No. _____, Recorded Plat _____ |   |     |   |    |     |
| 5. Private Claims _____               |   |     |   |    |     |

Register of Deeds Stamp & File Number

	A	B	C	D	E	F	G	H	I	J	K	L	M
2	6		5		4		3		2		1		
3													
4	7		8		9		10		11		12		
5													
6	18		17		16		15		14		13		
7													
8	19		20		21		22		23		24		
9													
10	30		29		28		27		26		25		
11													
12	31		32		33		34		35		36		
13													

I, CARL T. KIISKILA, in a field survey on JANUARY 22, 19 97, do hereby certify that under requirements of P.A. 74, Michigan P.A. of 1970, the corner points mentioned in lines 1 and 2 above were in conformance with regulations and rules therefore as required in the current manual of survey instructions of the United States Department of the Interior, Bureau of Land Management or by a decree of a Court of Law and/or that the corner points mentioned in lines 3, 4 and 5 above were in conformance with the rules of the Michigan Board of Land Surveyors or by a Decree of a Court of Law; established, re-established, monumented, re-monumented, recovered, found as expressed below:

**NOTE: Not more than 4 corners, all in the same town and range, may be recorded on this certificate.**

**A. Description of original monument and accessories and/or subsequent restoration:**

A-3

U.S. G.L.O. - SET SEC. POST CORNER SEC'S 1 & 12, T18N-R1E;  
 MEN 10 IN N51°W 30 LKS, MEN 11 IN S66°W 22 LKS.  
 NO SIGN OF GLO POST OR WIT'S.

**B. Description of corner evidence found and/or method applied in restoring or reestablishing corner:**


A-3

FB 1 1/2" PIPE FOR COR TO SEC'S 6 & 7, T18N-R2E & SEC'S 1 & 12, T18N-R1E. PIPE PROBABLY SET BY M.SCHAAF, CONSERVATION DEPT. SUVEYDR & FORESTER(1910 - 1940'S). OLD NARROW GRADE (NW-SE) IS 28' WEST.

**C. Description of monument for corner and accessories established to perpetuate locating the position of the corner:**

A-3

FB OLD 1 1/2" PIPE, REPLACED W/1" x 36" GALV. PIPE W/4" ALUMN BNR CAP, SET BLUE CARSONITE POST.  
 13" TW. MAPLE N55°W 53.04' (DROVE SPIKE & TAG NE SIDE)  
 8" MAPLE (CLP-5) N65°E 80.97' (DROVE SPIKE & TAG SE SIDE)  
 17" Y.PINE STP S40°E 12.77' (DROVE SPIKE & TAG NE SIDE)  
 4" TAMARACK S35°E 93.85' (DROVE SPIKE & TAG SW SIDE)  
 CLP 6 4" TO 9" MAPLES S35°W 22.49' (DROVE SPIKE & TAG NW SIDE)

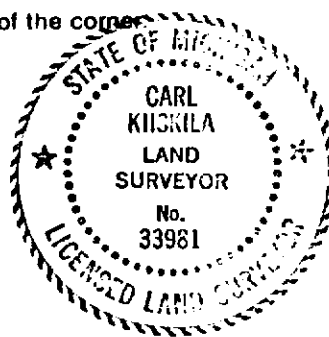

Signed by Carl T. Kiiskila Date 4-7-97  
 Surveyor's Michigan License No. 33981