LIBER 001 PAGE 158

GLADWIN COUNTY REMONUMENTATION

LAND CORNER RECORDATION CERTIFICATE
Filing Requirement of Act 74, Mich. P.A. 1970

STATE OF MICHIGAN
GLADWIN COUNTY
FILED -Remonumentation

17 OCT 97 1:17 P.M.

BONNIE K. HOUSE
REGISTER OF DEEDS

Register of Deeds Stamp & File Number

For corners in

GLADWIN (County)

	Located In:	Corner Code #
1. Public Land Survey	T 18N R 1W	A-5
	T___ R___	
	T___ R___	
	T___ R___	
2. Property Controlling	S___ T___ R___	
in Section	S___ T___ R___	
3. Miscellaneous	S___ T___ R___	
Property in Sec.	S___ T___ R___	

4. Lot No. _____, Recorded Plat _____
5. Private Claims _____

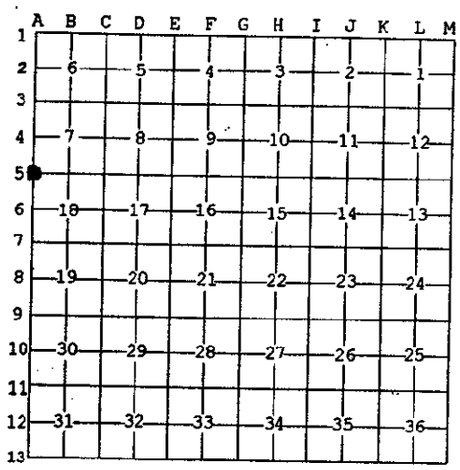

I, MARK R. ROBISON, in a field survey on May 22, 19 97 do hereby state that under requirements of P.A. 74, Michigan P.A. of 1970, the corner points mentioned in lines 1 and 2 above were in conformance with regulations and rules therefore as required in the current manual of survey instructions of the United States Department of the Interior, Bureau of Land Management or by a decree of a Court of Law and /or that the corner points mentioned in lines 3, 4 and 5 above were in conformance with the rules of the Michigan Board of Land Surveyors or by a Decree of a Court of Law; established, re-established, monumented, recovered, found as expressed below:

NOTE: Not more than 2 corners, all in the same town and range, may be recorded on this certificate.

A. Description of original monument and accessories and/or subsequent restoration:

1877 T. Gale Merrill
Set Post
Wit.-(1)S1E 16 links 8" Cedar
(2)N80E 30 links 6" Maple

1956 Moore survey
Wit.-(3)12" Oak N30W 99.6'
(4)12" Oak S50E 69.7'

1976 Lapham--Corner Found
Section Subd for Gladwin Cemetery

1978 +/- Lapham--Cor Reset from '76 surv.

1981 Lapham survey & working dwg.
Found capped iron

1983 Lapham survey & working dwg.

1989 Lapham survey
Wit.-none

APPROVED LAND CORNER
P.A. 345 of 1990
Gladwin County
Co. Rep. [signature]
Date 9/25/97

B. Description of corner evidence found and/or method applied in restoring or reestablishing corner:

Found capped iron #9433 in centerline of constructed trail road East of river in low wooded area. Set Gladwin County Re-mon in place of found iron.

See dossier for detailed report.

C. Description of monument for corner and accessories established to perpetuate locating the position of the corner:

A-5: Corner on township line, common to Sections 7 & 18.
Set 5/8" x 36" rerod with Gladwin County Re-mon Cap marked P.S.#27458.

Witnesses:
S75W 18" Cedar, nail & tag, 40.20'
N05E 12" Ash, nail & tag, 27.15'
S08E 12" Ash, nail & tag, 36.86'
N30W 8" Maple, nail & tag, 46.70'
Corner common to Sections 12 & 13, T18N, R2W.

SURVEY & REMONUMENTATION
JAN 0 8 1998
SECTION

Signed by [signature]
Surveyor's Michigan License No. 27458

STATE OF MICHIGAN
MARK R. ROBISON
PROFESSIONAL SURVEYOR
No. 27458
LICENSED PROFESSIONAL SURVEYOR

Date 10-7-97

FORM APPROVED BY MICHIGAN STATE BOARD OF PROFESSIONAL SURVEYORS, JAN. 28, 1971
REVISED MAY 14,1975
REVISED JAN., 1983
REVISED OCT., 1995