

GLADWIN COUNTY REMONUMENTATION

LIBER 001 PAGE 160

LAND CORNER RECORDATION CERTIFICATE
Filing Requirement of Act 74, Mich. P.A. 1970

STATE OF MICHIGAN
GLADWIN COUNTY
FILED - Remonumentation

For corners in

<u>GLADWIN</u> (County)	Located in:	Corner Code #
1. Public Land Survey	T 18N R 1W	B-5
	T R	
	T R	
	T R	
2. Property Controlling in Section	S T R	
	S T R	
3. Miscellaneous Property in Sec.	S T R	
	S T R	
4. Lot No. _____, Recorded Plat _____		
5. Private Claims _____		

17 OCT 97 1:17 P.M.

BONNIE K. HOUSE
REGISTER OF DEEDS

Register of Deeds Stamp & File Number

I, MARK R. ROBISON, in a field survey on May 22, 19 97 do hereby state that under requirements of P.A. 74, Michigan P.A. of 1970, the corner points mentioned in lines 1 and 2 above were in conformance with regulations and rules therefore as required in the current manual of survey instructions of the United States Department of the Interior, Bureau of Land Management or by a decree of a Court of Law and/or that the corner points mentioned in lines 3, 4 and 5 above were in conformance with the rules of the Michigan Board of Land Surveyors or by a Decree of a Court of Law; established, re-established, monumented, recovered, found as expressed below:

NOTE: Not more than 2 corners, all in the same town and range, may be recorded on this certificate.

	A	B	C	D	E	F	G	H	I	J	K	L	M
1													
2	6		5		4		3		2		1		
3													
4	7		8		9		10		11		12		
5													
6	18		17		16		15		14		13		
7													
8	19		20		21		22		23		24		
9													
10	30		29		28		27		26		25		
11													
12	31		32		33		34		35		36		
13													

- A. Description of original monument and accessories and/or subsequent restoration:
- 1877 T. Gale Merrill Set Post
 - Wit.-(1)S64E 13 links 7" Cedar
 - (2)N09W 17 links 4" Hemlock
 - 1982 Lapham L.C.R.C.#259 Found R.R. Spike
 - Wit.-(3)N35E P.P. 45.30'
 - (4)N40W Fe. Post 34.27'
 - (5)S50W 2" Pipe 29.85'
 - 1981 Lapham survey Found R/R Spike
 - 1983 Lapham survey Found R/R spike
 - 1981 Lapham-working drawing

APPROVED LAND CORNER
P.A. 346 of 1990
Gladwin County

Co. Rep. [Signature]
Date 9/25/97

- B. Description of corner evidence found and/or method applied in restoring or reestablishing corner:
- Found R/R spike in approximate centerline of T-road N-S-E, 1' below surface. Found (3) as recorded and measured to face. Found (5); recorded 29.85', measured 29.80'. Set Gladwin County Re-mon in place of found R/R spike.

See Dossier for detailed report.

- C. Description of monument for corner and accessories established to perpetuate locating the position of the corner:

B-5: Corner common to Sections 7 & 18.
Set 5/8" x 36" rerod with Gladwin County Re-mon Cap marked P.S.#27458.


SURVEY &
REMONUMENTATION

JAN 0 8 1998

SECTION

- Witnesses:
- S45E 16" Ash, nail & tag, 82.89'
 - N40W Corner Fence Post, nail & tag, 38.25'
 - S80W 2" x 6' stan-pipe 29.80'
 - N30E P.P., nail & tag, 45.78'
 - S45W 1/2" x 36" Re-rod in centerline of drive to West

Signed by [Signature]
Surveyor's Michigan License No. 27458

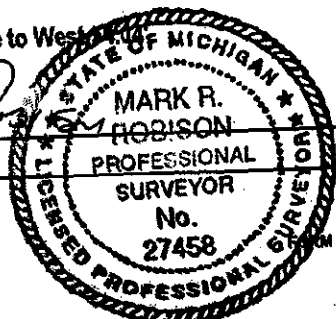

Date 10-7-97