

GLADWIN COUNTY REMONUMENTATION

USER 001 PAGE 175

LAND CORNER RECORDATION CERTIFICATE  
Filing Requirement of Act 74, Mich. P.A. 1970

For corners in

<u>GLADWIN</u> (County)	Located In:	Corner Code #
1. Public Land Survey	T <u>18N</u> R <u>1W</u>	<u>C-1</u>
	T <u>    </u> R <u>    </u>	<u>    </u>
	T <u>    </u> R <u>    </u>	<u>    </u>
	T <u>    </u> R <u>    </u>	<u>    </u>
2. Property Controlling in Section	S <u>    </u> T <u>    </u> R <u>    </u>	<u>    </u>
	S <u>    </u> T <u>    </u> R <u>    </u>	<u>    </u>
3. Miscellaneous Property in Sec.	S <u>    </u> T <u>    </u> R <u>    </u>	<u>    </u>
	S <u>    </u> T <u>    </u> R <u>    </u>	<u>    </u>

STATE OF MICHIGAN  
GLADWIN COUNTY  
FILED - Remonumentation

17 OCT 97 1:20 P.M.

BONNIE K. HOUSE  
REGISTER OF DEEDS

Register of Deeds Stamp & File Number

4. Lot No. \_\_\_\_\_, Recorded Plat \_\_\_\_\_  
5. Private Claims \_\_\_\_\_

I, MARK R. ROBISON, in a field survey on April 6, 19 97, do hereby state that under requirements of P.A. 74, Michigan P.A. of 1970, the corner points mentioned in lines 1 and 2 above were in conformance with regulations and rules therefore as required in the current manual of survey instructions of the United States Department of the Interior, Bureau of Land Management or by a decree of a Court of Law and for that the corner points mentioned in lines 3, 4 and 5 above were in conformance with the rules of the Michigan Board of Land Surveyors or by a Decree of a Court of Law; established, re-established, monumented, recovered, found as expressed below:

NOTE: Not more than 2 corners, all in the same town and range, may be recorded on this certificate.

A	B	C	D	E	F	G	H	I	J	K	L	M
1												
2	6	5	4	3	2	1						
3												
4	7	8	9	10	11	12						
5												
6	18	17	16	15	14	13						
7												
8	19	20	21	22	23	24						
9												
10	30	29	28	27	26	25						
11												
12	31	32	33	34	35	36						
13												

A. Description of original monument and accessories and/or subsequent restoration:

1877 T. Gale Merrill Set Post Wit.-(1)S45E 48 links 24" Pine (2)S65W 12 links 12" Maple	1985 Lapham survey Found 1/2" iron Wit.-(6)S10E 6" Pine 43.10' (7)N60E Power Pole 94.75' (8)N45W 6" Willow 66.30'
1974 Lapham L.C.R.C.#89 and survey Found 1/4" rod Wit.-(3)S10E 43.10' - 6" Pine Tree (4)N60E 94.75' Power Pole (5)N45W 66.3' - 6" Willow Tree	1985 Lapham working drawing  1994 Lapham survey Wit.-same as (6),(7)&(8)

APPROVED LAND CORNER  
P.A. 345 of 1990  
Gladwin County

Co. Rep. [Signature]  
Date 9/18/97

B. Description of corner evidence found and/or method applied in restoring or reestablishing corner:

Found 3/8" rod in 3/4" pipe 1.5" below surface in centerline of county road 2' west of fence to South. Found (3) & (6); nail & tag, measured 43.05', recorded 43.10'. Found (7), nail & tag, recorded and measured 94.75'. Set Gladwin County Re-mon over found 3/4" iron pipe

GLO recorded 99.00, measured 99.05.

See dossier for detailed report.

C. Description of monument for corner and accessories established to perpetuate locating the position of the corner:

C-1: Corner common to Sections 5 & 6.  
Set 5/8" x 36" rerod with Gladwin County Re-mon Cap marked P.S.#27458.


Witnesses:  
N60E Power Pole, nail & tag, 94.75'  
S10E 16" W. Pine, nail & tag, 43.05'  
N05E SW corner house, block, 64.35'  
S55E 8" Spruce, N&T, 78.95' West, SE Cor, Sec 31, T19N, R1W, 99.05'

SURVEY &  
REMONUMENTATION

JAN 08 1998

SECTION

Signed by Mark R. Robison  
Surveyor's Michigan License No. 27458

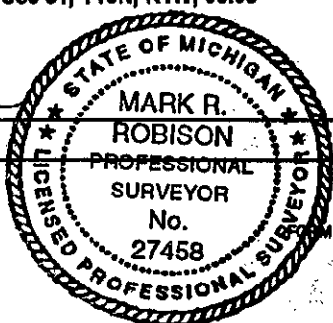

Date 10-7-97