

GLADWIN COUNTY REMONUMENTATION

LAND CORNER RECORDATION CERTIFICATE
Filing Requirement of Act 74, Mich. P.A. 1970

LIBER 001 PAGE 176

For corners in

<u>GLADWIN</u> (County)	Located In:	Corner Code #
1. Public Land Survey	T <u>18N</u> R <u>1W</u>	<u>D-1</u>
	T <u> </u> R <u> </u>	<u> </u>
	T <u> </u> R <u> </u>	<u> </u>
	T <u> </u> R <u> </u>	<u> </u>
2. Property Controlling in Section	S <u> </u> T <u> </u> R <u> </u>	<u> </u>
	S <u> </u> T <u> </u> R <u> </u>	<u> </u>
3. Miscellaneous Property in Sec.	S <u> </u> T <u> </u> R <u> </u>	<u> </u>
	S <u> </u> T <u> </u> R <u> </u>	<u> </u>

STATE OF MICHIGAN
GLADWIN COUNTY
FILED - Remonumentation

17 OCT 97 1:20 P.M.

BONNIE K. HOUSE
REGISTER OF DEEDS

Register of Deeds Stamp & File Number

4. Lot No. _____, Recorded Plat _____
5. Private Claims _____

	A	B	C	D	E	F	G	H	I	J	K	L	M
1													
2	6		5		4		3		2		1		
3													
4	7		8		9		10		11		12		
5													
6	18		17		16		15		14		13		
7													
8	19		20		21		22		23		24		
9													
10	30		29		28		27		26		25		
11													
12	31		32		33		34		35		36		
13													

I, MARK R. ROBISON, in a field survey on May 5, 19 97 do hereby state that under requirements of P.A. 74, Michigan P.A. of 1970, the corner points mentioned in lines 1 and 2 above were in conformance with regulations and rules therefore as required in the current manual of survey instructions of the United States Department of the Interior, Bureau of Land Management or by a decree of a Court of Law and for that the corner points mentioned in lines 3, 4 and 5 above were in conformance with the rules of the Michigan Board of Land Surveyors or by a Decree of a Court of Law; established, re-established, monumented, recovered, found as expressed below:

NOTE: Not more than 2 corners, all in the same town and range, may be recorded on this certificate.

A. Description of original monument and accessories and/or subsequent restoration:

- 1877 T. Gale Merrill
No corner set
- 1975 Lapham L.C.R.C.#27
Found 3/4" iron bar
Wit.-(1)South 20.6' Power Pole
(2)N30W 188.40' Power Pole
(3)S05E 31.61' Fence Corner
- 1985 Lapham
Wit.-same as (1),(2)&(3)

APPROVED LAND CORNER
P.A. 245 of 1990
Gladwin County

Co. Rep. [Signature]
Date 9/12/97

B. Description of corner evidence found and/or method applied in restoring or reestablishing corner:

Found 3/4" x 14" iron stake 24" below surface of centerline of county road opposite fence and tree line to South. Set Gladwin County Re-mon in place of found iron.

See dossier for detailed report.

C. Description of monument for corner and accessories established to perpetuate locating the position of the corner:

D-1: Corner on township line, Section 5.
Set 5/8" x 36" rered with Gladwin County Re-mon Cap marked P.S.#27458.


- Witnesses:
- N32W 10" Clump of Maples, nail & tag, 47.52'
 - N22E 8" Maple, nail & tag, 48.90'
 - S05E 8" Pine, nail & tag, 72.42'
 - S40E 8" Pine, nail & tag, 45.75'
 - West, S 1/4 Cor., Sec. 32, T19N, R1W, Gladwin County, Mich.

SURVEY &
REMONUMENTATION

JAN 08 1998

SECTION

Signed by [Signature]
Surveyor's Michigan License No. 27458

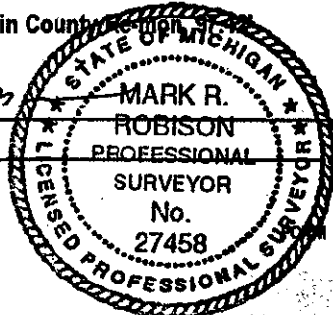

Date 10-7-97