

GLADWIN COUNTY REMONUMENTATION
LAND CORNER RECORDATION CERTIFICATE
 Filing Requirement of Act 74, Mich. P.A. 1970

LIBER **001** PAGE **177**

For corners in

GLADWIN
 (County)

Located In: Corner Code #

- | | | |
|------------------------------------|--------------------------|------------|
| 1. Public Land Survey | T <u>18N</u> R <u>1W</u> | <u>E-1</u> |
| | T ___ R ___ | _____ |
| | T ___ R ___ | _____ |
| | T ___ R ___ | _____ |
| 2. Property Controlling in Section | S ___ T ___ R ___ | _____ |
| | S ___ T ___ R ___ | _____ |
| 3. Miscellaneous Property in Sec. | S ___ T ___ R ___ | _____ |
| | S ___ T ___ R ___ | _____ |
4. Lot No. _____, Recorded Plat _____
 5. Private Claims _____

STATE OF MICHIGAN
 GLADWIN COUNTY
 FILED -Remonumentation

17 OCT 97 1:20 P.M.

BONNIE K. HOUSE
 REGISTER OF DEEDS

Register of Deeds Stamp & File Number

I, MARK R. ROBISON, in a field survey on May 23, 19 97 do hereby state that under requirements of P.A. 74, Michigan P.A. of 1970, the corner points mentioned in lines 1 and 2 above were in conformance with regulations and rules therefore as required in the current manual of survey instructions of the United States Department of the Interior, Bureau of Land Management or by a decree of a Court of Law and /or that the corner points mentioned in lines 3, 4 and 5 above were in conformance with the rules of the Michigan Board of Land Surveyors or by a Decree of a Court of Law; established, re-established, monumented, recovered, found as expressed below.

NOTE: Not more than 2 corners, all in the same town and range, may be recorded on this certificate.

1	A	B	C	D	E	F	G	H	I	J	K	L	M
2		6		5		4		3		2		1	
3													
4		7		8		9		10		11		12	
5													
6		10		17		16		15		14		13	
7													
8		19		20		21		22		23		24	
9													
10		30		29		28		27		26		25	
11													
12		31		32		33		34		35		36	
13													

A. Description of original monument and accessories and/or subsequent restoration:

1877 T. Gale Merrill
 Set Post
 Wit.-(1)S48W 20 links 30" Pine
 (2)S20E 3 links 8" Ash

1960 +/- Edmands Eng.-worksheet
 Found wood stake 2" x 2" - 2' deep
 Wit.-(3)58.65' P.P. NW
 (4)38.2' - 4" Steel Post

1971 Cavanagh survey
 Found 1/2" bar

1971 Lapham L.C.R.C.#27
 Found 2" x 2" stake
 Wit.-same as (3)&(4)

1977 Lapham L.C.R.C.#191

Found 3/8" iron
 Wit.-(5)N25W 58.64' Power Pole
 (6)N30E 99.28' - 10" Birch
 (7)N65E 32.62' Cor Fence Post

1984 Lapham survey
 Wit.-same as (5),(6)&(7)

Lapham-two working drawings

B. Description of corner evidence found and/or method applied in restoring or reestablishing corner:

Found 3/8" rod 8' South and 3' West of intersection of T-road S-E-W. Found (3). Found (5); recorded 58.64', measured 58.61'. Set Gladwin County Re-mon in place of found 3/8" rerod.

GLO recorded 114.84, measured 134.65 offset corner.

See dossier for detailed report.

APPROVED LAND CORNER
 P.A. 845 of 1990
 Gladwin County

Co. Rep. John Meyer

Date 9/10/97

C. Description of monument for corner and accessories established to perpetuate locating the position of the corner:


E-1: Corner on township line, common to Sections 4 & 5.
 Set 5/8" x 36" rerod with Gladwin County Re-mon Cap marked P.S.#27458.

Witnesses:

- N35W Power Pole, nail & tag, 58.61'
- S30W 5" Jack Pine, nail & tag, 83.12'
- S65W 10" Jack Pine, nail & tag, 102.82'
- S70E 3" White Pine, nail & tag, 79.75'
- N85W SE corner, Section 32, T19N, R1W, 134.65'

Signed by

Surveyor's Michigan License No. 27458

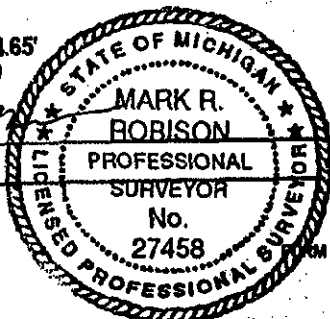

Date 10-7-97

SURVEY &
 REMONUMENTATION

JAN 0 8 1998

SECTION