

GLADWIN COUNTY REMONUMENTATION

LIBER 001 PAGE 171

LAND CORNER RECORDATION CERTIFICATE  
Filing Requirement of Act 74, Mich. P.A. 1970

For corners in

GLADWIN

(County)

Located In:

Corner Code #

1. Public Land Survey	T 18N R 1W	E-3
	T R	
	T R	
	T R	
2. Property Controlling in Section	S T R	
	S T R	
3. Miscellaneous Property in Sec.	S T R	
	S T R	

STATE OF MICHIGAN  
GLADWIN COUNTY  
FILED - Remonumentation

17 OCT 97 1:19 P.M.

BONNIE K. HOUSE  
REGISTER OF DEEDS

Register of Deeds Stamp & File Number

4. Lot No. \_\_\_\_\_, Recorded Plat \_\_\_\_\_  
5. Private Claims \_\_\_\_\_

I, MARK R. ROBISON, in a field survey on May 6, 1997 do hereby state that under requirements of P.A. 74, Michigan P.A. of 1970, the corner points mentioned in lines 1 and 2 above were in conformance with regulations and rules therefore as required in the current manual of survey instructions of the United States Department of the Interior, Bureau of Land Management or by a decree of a Court of Law and /or that the corner points mentioned in lines 3, 4 and 5 above were in conformance with the rules of the Michigan Board of Land Surveyors or by a Decree of a Court of Law; established, re-established, monumented, recovered, found as expressed below:

NOTE: Not more than 2 corners, all in the same town and range, may be recorded on this certificate.

1	A	B	C	D	E	F	G	H	I	J	K	L	M
2		6		5		4		3		2		1	
3					●								
4		7		8		9		10		11		12	
5													
6		16		17		16		15		14		13	
7													
8		19		20		21		22		23		24	
9													
10		30		29		28		27		26		25	
11													
12		31		32		33		34		35		36	
13													

A. Description of original monument and accessories and/or subsequent restoration:

1877 T. Gale Merrill  
Set Post  
Wit.-(1)N65W 15 links 17" Aspen  
(2)S35E 16 links 8" Pine

1974 Courtwright L.C.R.C.#84  
5/8" x 18" Rod  
Wit.-(7)Fence Post 10.94' S45W  
(8)6" Poplar 29.10' N80E  
(9)Fence Post 36.58' S85E

1979 Lapham survey  
Wit.-(13)West 33.00' - Iron  
(14)S45E 30.50' - 6" Poplar  
(15)N45E 21.25' - 6" Poplar

1960 Edmands  
Set iron  
Wit.-(5)Cor Fence Post 19.8 West  
(6)Face 2nd Post South 34.8' SW

1974 Lapham L.C.R.C.#98  
Set Capped Iron  
Wit.-(10)West 21.80' Fence Corner  
(11)N45E 21.29' - 6" Poplar  
(12)S40E 30.46' - 4" Poplar

1980 Lapham L.C.R.C.#236  
Found Capped Iron  
Wit.-same as (13),(14)&(15)

1988 Lapham survey  
Wit.-same as (14)&(15)

B. Description of corner evidence found and/or method applied in restoring or reestablishing corner:

Found 1/2" x 18" reroed in centerline of unimproved county road opposite old fence East & West. Found (10); old fence corner rotted off, measured to center of base 22' +/-, Recorded 21.80'. Found (13); capped iron, recorded and measured 33.00'. Found (11); 14" Poplar, measured 21.5' to center, recorded 21.29'. Set Gladwin County Re-mon in place of found iron.

See dossier for detailed report.

APPROVED LAND CORNER  
P.A. 345 of 1990  
Gladwin County

Co. Rep. [Signature]  
Date 5/18/97

C. Description of monument for corner and accessories established to perpetuate locating the position of the corner:

E-3: Corner common to Sections 4, 5, 8 & 9.  
Set 5/8" x 36" reroed with Gladwin County Re-mon Cap marked P.S.#27458.


Witnesses:  
N40W 8" Poplar, nail & tag, 61.25'  
N75E 6" Poplar, nail & tag, 84.90'  
N85E 4" Poplar, nail & tag, 28.75'  
S45E 1/2" x 36" reroed 42.80'  
West capped iron #9433 33.00'

SURVEY &  
REMONUMENTATION

JAN 0 8 1998

SECTION

Signed by [Signature]  
Surveyor's Michigan License No. 27458

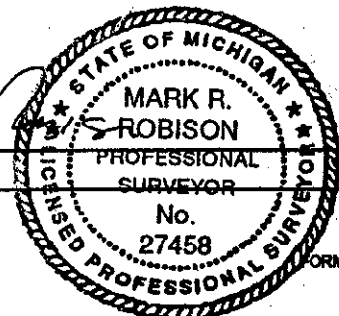

Date 10-7-97