

GLADWIN COUNTY REMONUMENTATION

LIBER 001 PAGE 178

LAND CORNER RECORDATION CERTIFICATE
Filing Requirement of Act 74, Mich. P.A. 1970

For corners in

GLADWIN

(County)

Located in:

Corner Code #

- | | | |
|------------------------------------|--------------------------|------------|
| 1. Public Land Survey | T <u>18N</u> R <u>1W</u> | <u>F-1</u> |
| | T _____ R _____ | _____ |
| | T _____ R _____ | _____ |
| | T _____ R _____ | _____ |
| 2. Property Controlling in Section | S _____ T _____ R _____ | _____ |
| | S _____ T _____ R _____ | _____ |
| 3. Miscellaneous Property in Sec. | S _____ T _____ R _____ | _____ |
| | S _____ T _____ R _____ | _____ |

STATE OF MICHIGAN
GLADWIN COUNTY
FILED - Remonumentation

17 OCT 97 1:20 P.M.

BONNIE K. HOUSE
REGISTER OF DEEDS

Register of Deeds Stamp & File Number

4. Lot No. _____, Recorded Plat _____
5. Private Claims _____

I, MARK R. ROBISON, in a field survey on May 2, 19 97 do hereby state that under requirements of P.A. 74, Michigan P.A. of 1970, the corner points mentioned in lines 1 and 2 above were in conformance with regulations and rules therefore as required in the current manual of survey instructions of the United States Department of the Interior, Bureau of Land Management or by a decree of a Court of Law and /or that the corner points mentioned in lines 3, 4 and 5 above were in conformance with the rules of the Michigan Board of Land Surveyors or by a Decree of a Court of Law, established, re-established, monumented, recovered, found as expressed below:

NOTE: Not more than 2 corners, all in the same town and range, may be recorded on this certificate.

	A	B	C	D	E	F	G	H	I	J	K	L	M
1													
2	6		5		4		3		2		1		
3													
4	7		8		9		10		11		12		
5													
6	18		17		16		15		14		13		
7													
8	19		20		21		22		23		24		
9													
10	30		29		28		27		26		25		
11													
12	31		32		33		34		35		36		
13													

A. Description of original monument and accessories and/or subsequent restoration:

- | | | |
|---|---|---|
| 1877 T. Gale Merrill
No corner set | 1973 Lapham
Found 1/2" bar
Wit-same as (1)&(2)
(3)S50E 24.75' - 20" Twin Maple | 1977 Sedgman L.C.R.C.#191
Found 1/2" bar
Wit-(4)N45W 59.70' 10" Ash
(5)N40E 42.50' 10" Ash
(6)S30W 69.39' 10" Maple
(7)S45E 24.82' 30" Maple |
| 1969 Lapham
Found 1/2" bar
Wit-(1)NW culvert 37.3'
(2)SW culvert 37.5' | 1973 Lapham L.C.R.C.#68
Wit-same as (1),(2)&(3) | 1984-88 Lapham surveys
Wit-same as (1),(2)&(3) |

B. Description of corner evidence found and/or method applied in restoring or reestablishing corner:

Found two 1/2" x 18" rods, side by side, 6" below surface in centerline of road opposite fence to South. Found (4); measured 59.8' to center of tree and blaze, recorded 59.7'. Found (6); measured 69.4' to center of tree and blaze, recorded 69.39'. Set Gladwin County Re-mon in place of found irons.

See dossier for detailed report.

APPROVED LAND CORNER
P.A. 345 of 1990
Gladwin County

Co. Rep. [Signature]
Date 9/18/97

C. Description of monument for corner and accessories established to perpetuate locating the position of the corner:

F-1: Corner on township line, Section 4.
Set 5/8" x 36" rod with Gladwin County Re-mon Cap marked P.S.#27458.


- Witnesses:
S30W 14" Maple, nail & tag, 69.60'
S20E 12" Ash, nail & tag, 43.72'
S45E 10" Pine, nail & tag, 81.58'
N50W 12" Ash, nail & tag, 60.00'
West, S 1/4 Cor., Sec. 33, T19N, R1W, Gladwin County, Mich.

SURVEY &
REMONUMENTATION

JAN 08 1998

SECTION

Signed by [Signature]
Surveyor's Michigan License No. 27458

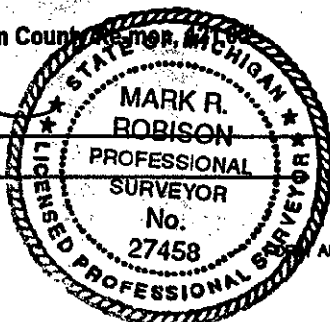

Date 10-7-97