

**SURVEY &  
REMONUMENTATION**

JAN 17 1996

**COMMISSION**

**LAND CORNER RECORDATION CERTIFICATE**  
Filing Requirement of Act 74, Mich. P.A. 1970

For corners in

LIBER **001** PAGE **74**

<u>GLADWIN</u> (County)	Located In:	Corner Code #
1. Public Land Survey	T <u>18N</u> R <u>1W</u>	<u>G-3</u>
	T _____ R _____	_____
	T _____ R _____	_____
	T _____ R _____	_____
2. Property Controlling in Section	S _____ T _____ R _____	_____
	S _____ T _____ R _____	_____
3. Miscellaneous Property in Sec.	S _____ T _____ R _____	_____
	S _____ T _____ R _____	_____

STATE OF MICHIGAN  
GLADWIN COUNTY  
FILED-REMONUMENTATION

26 DEC 95 10:50 A.M.


BONNIE K. HOUSE  
REGISTER OF DEEDS

Register of Deeds Stamp & File Number

4. Lot No. \_\_\_\_\_, Recorded Plat \_\_\_\_\_  
5. Private Claims \_\_\_\_\_

I, PAUL B. LAPHAM, in a field survey on MAY-NOVEMBER, 19 95 do hereby state that under requirements of P.A. 74, Michigan P.A. of 1970, the corner points mentioned in lines 1 and 2 above were in conformance with regulations and rules therefore as required in the current manual of survey instructions of the United States Department of the Interior, Bureau of Land Management or by a decree of a Court of Law and/or that the corner points mentioned in lines 3, 4 and 5 above were in conformance with the rules of the Michigan Board of Land Surveyors or by a Decree of a Court of Law; established, re-established, monumented, recovered, found as expressed below:

NOTE: Not more than 2 corners, all in the same town and range, may be recorded on this certificate.

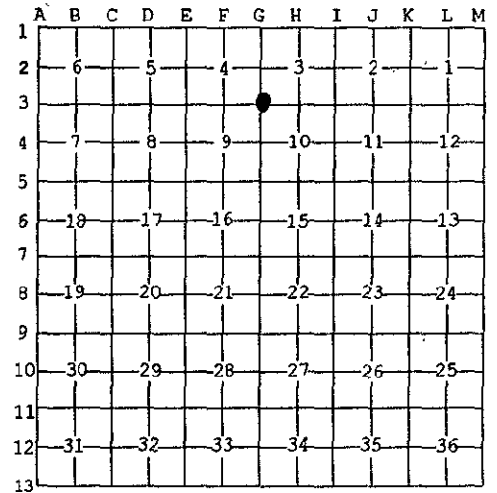


**A. Description of original monument and accessories and/or subsequent restoration:**

- |  |  |  |
|--|--|--|
| 1877 T. GALE MERRILL<br>SET POST<br>WIT.-(1)CEDAR 16" N78°E 22<br>(2)CEDAR 15" S11°W 19  | 1975 LAPHAM L.C.R.C. #106<br>FOUND 1/2" IRON<br>WIT.-(7)N60°E 63.43' 8" OAK<br>(8)S60°E 49.73' 4" STEEL POST<br>(9)WEST 23.72' 5" FENCE POST             | 1978 LAPHAM SURVEY &<br>WORKING DWG. #782045<br>WIT.-SAME AS (7), (8) & (9)  |
| 1960± EDMANDS DWG'S WORK SHEETS<br>SET IRON<br>WIT.-(3)SPIKE IN 24" MAPLE 31.00' N.E.<br>(4)SPIKE IN COR. FENCE POST 35.76' S.E. | 1977 LAPHAM L.C.R.C. #201<br>WIT.-(10)N40°E 72.47' APPLETREE<br>(11)N85°W 33.65' FENCE POST<br>(12)S45°E 50.00' 4" PIPE POST<br>(13)S45°E 63.47' 14" OAK | 1986 LAPHAM SURVEY &<br>WORKING DWG. #G-866118<br>WIT.-SAME AS (10), (11), & (13)  |
| 1974 COURTRIGHT L.C.R.C. #84<br>FOUND 1/2" ROD, 2" D.P.<br>WIT.-(5)3" MAPLE 31.87' N40°E<br>(6)5" GAS LINE MARKER 49.80', S75°E  | 1977 LAPHAM SLURVEY & WORK DWG. #771393<br>WIT.-SAME AS (10), (11), (12) & (13)  | 1990 LAPHAM SURVEY &<br>WORKING DWG. #G-900534<br>FOUND 1/2" IRON<br>WIT.-(14)N60°E 63.43' 8" OAK<br>(15)S60°E 49.73' 4" STEEL POST<br>(16)WEST 33.72' 5" FENCE POST |

**B. Description of corner evidence found and/or method applied in restoring or reestablishing corner:**

- |  |  |
|--|--|
| A.(CONTINUED)<br>1994 LAPHAM SURVEY #G-945608<br>WIT.-SAME AS (14), (15), & (16) | 1994 LAPHAM UNRECORDED L.C.R.C. FOR<br>COUNTY ROAD CONSTRUCTION<br>FD. 1/2" RE-ROD, RESET AFTER CONST.<br>CAPPED IRON<br>WIT.-(17)N35°E POWER POLE 55.95'<br>(18)S75°E E. N.W. FACE GAS MARKER 49.75'<br>(19)N70°W POWER POLE 107.80'<br>(20)S45°W FENCE POST 39.30' |
|--|--|

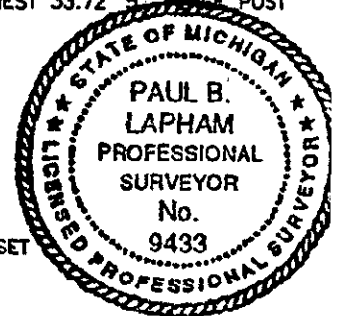

FOUND CAPPED IRON, EXCAVATED, FOUND 1/2" IRON AT 1.5 BELOW SURFACE OF INTER. ASPHALT ROADS, SET RE-MON COR. IN BOTTOM LOCATION OF FOUND 1/2" ROD, WITNESSES FD. (6) REC. 49.80' MEAS. 49.70', FOUND (7) FOUND 12" OAK MEAS. 62.8' TO FACE, REC. 63.43'

This Corner established in Gladwin County Remonumentation Program.  
See dossier for detailed report.

**C. Description of monument for corner and accessories established to perpetuate locating the position of the corner:**

G-3: CORNER COMMON TO SECTIONS 3, 4, 9 & 10  
SET 5/8"x36" RE-ROD WITH GLADWIN COUNTY RE-MON CAP IN MON. BOX MARKED P.S. #9433

- WITNESSES:  
N35°E 55.95' - NAIL & TAG IN POWER POLE  
N70°W 107.80' - NAIL & TAG IN POWER POLE  
N60°E 63.27' - NAIL & TAG IN 14" OAK  
S75°E 49.70' - 5" GAS LINE MARKER  
BROKEN OFF AT GROUND LEVEL  
NORTH P.K. NAIL 2.0'  
EAST P.K. NAIL 2.0'

**APPROVED LAND CORNER**  
P.A. 345 of 1990  
Gladwin County

Co. Rep. *Paul B. Lapham*  
Date 12/14/95

Signed by *Paul B. Lapham*  
Surveyor's Michigan License No. 9433

Date 12-22-95