

**SURVEY &
REMONUMENTATION**

JAN 17 1996

COMMISSION

LAND CORNER RECORDATION CERTIFICATE
Filing Requirement of Act 74, Mich. P.A. 1970

LIBER **001** PAGE **75**

For corners in

<u>GLADWIN</u> (County)	Located In:	Corner Code #
1. Public Land Survey	T <u>18N</u> R <u>1W</u>	<u>G-4</u>
	T <u> </u> R <u> </u>	<u> </u>
	T <u> </u> R <u> </u>	<u> </u>
	T <u> </u> R <u> </u>	<u> </u>
2. Property Controlling In Section	S <u> </u> T <u> </u> R <u> </u>	<u> </u>
	S <u> </u> T <u> </u> R <u> </u>	<u> </u>
3. Miscellaneous Property in Sec.	S <u> </u> T <u> </u> R <u> </u>	<u> </u>
	S <u> </u> T <u> </u> R <u> </u>	<u> </u>

STATE OF MICHIGAN
GLADWIN COUNTY
FILED-REMONUMENTATION

26 DEC 95 10:51 A.M.

BONNIE K. HOUSE
REGISTER OF DEEDS

Register of Deeds Stamp & File Number

4. Lot No. _____, Recorded Plat _____
5. Private Claims _____

I, PAUL B. LAPHAM, in a field survey on MAY-NOVEMBER, 19 95 do hereby state that under requirements of P.A. 74, Michigan P.A. of 1970, the corner points mentioned in lines 1 and 2 above were in conformance with regulations and rules therefore as required in the current manual of survey instructions of the United States Department of the Interior, Bureau of Land Management or by a decree of a Court of Law and/or that the corner points mentioned in lines 3, 4 and 5 above were in conformance with the rules of the Michigan Board of Land Surveyors or by a Decree of a Court of Law; established, re-established, monumented, recovered, found as expressed below.

NOTE: Not more than 2 corners, all in the same town and range, may be recorded on this certificate.

A	B	C	D	E	F	G	H	I	J	K	L	M
1												
2	6	5	4	3	2	1						
3												
4	7	8	9	10	11	12						
5												
6	18	17	16	15	14	13						
7												
8	19	20	21	22	23	24						
9												
10	30	29	28	27	26	25						
11												
12	31	32	33	34	35	36						
13												

A. Description of original monument and accessories and/or subsequent restoration:

1877 T. GALE MERRILL
WIT.-(1)HEMLOCK 18 FOR CORNER

1960± EDMANDS FIELD NOTES & DWG.
SET IRON
WIT.-(2)SPIKE IN 12" MAPLE 59.05' N.E.
(3)SPIKE IN TELE. POLE 51.00' N.W.

1974 COURTRIGHT L.C.R.C. #84
FOUND 5/8" ROD
WIT.-(4)16" MAPLE 67.53' N76°E
(5)FENCE POST 54.75' S45°E

1977 LAPHAM SURVEY #771393
FOUND 5/8" IRON
WIT.-(6)S35°E 49.48' FENCE COR.
(7)WEST 33.78' FENCE COR.
(8)N45°E 58.49' 20" MAPLE
(9)N45°W 38.75' S.E. COR.
CONCRETE WALK

1978 LAPHAM SURVEY #782095
FOUND 5/8" IRON
WIT.-(10)N73°E 16" MAPLE 67.53'
(11)S45°E FE POST 34.74'
(12)N.E. 12" MAPLE 59.05'
(13)N.W. TELE. POLE 51.00'

1978 LAPHAM SURVEY #782045
FOUND 5/8" IRON
WIT.-SAME AS (10), (11), (12) & (13)

1984 LAPHAM SURVEY #844583
WIT.-SAME AS (6), (7) & (8)

1990 LAPHAM SURVEY #900534
SAME AS SURVEY #782095

B. Description of corner evidence found and/or method applied in restoring or reestablishing corner.

A. (CONTINUED)
1991 LAPHAM UNRECORDED L.C.R.C.
FOR COUNTY ROAD CONSTRUCTION
FOUND 5/8" IRON, SET CAPPED IRON
AFTER CONSTRUCTIONS
WIT.-(14)N45°E 20" MAPLE 58.20'
(15)S35°E FENCE COR. 49.85'
(16)WEST FENCE COR. 33.55'
(17)S35°W FENCE POST 55.85'


FOUND 1/2" IRON 2' WEST OF CENTER LINE AT T-ROAD EAST, EXCAVATED NO OTHER CORNER FOUND, SET GLADWIN RE-MON FROM WITNESSES & FOUND IRON, FOUND WITNESSES (8) & (12) MEAS. TO PIPE IN MAPLE 58.15', REC. 58.49' & 59.05' FOUND WITNESSES (9) MEAS. 38.8', REC. 38.75'

This Corner established in Gladwin County Remonumentation Program.
See dossier for detailed report.

C. Description of monument for corner and accessories established to perpetuate locating the position of the corner:

G-4: CORNER COMMON TO SECTIONS 9 & 10
SET 5/8"x36" RE-ROD WITH GLADWIN COUNTY RE-MON CAP IN MON. BOX MARKED P.S. #9433

WITNESSES:
N45°E 58.15' - 20" MAPLE, PIPE IN TREE
WEST 33.80' - NAIL & TAG IN CORNER POST
S45°W 106.65' - NAIL & TAG IN 3" BIRCH
N45°W 38.80' - S.E. CORNER CONCRETE WALK
EAST P.K. NAIL 2.0'
NORTH P.K. NAIL 2.0'

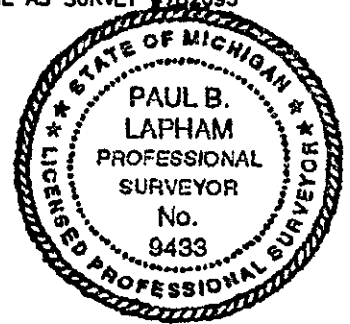

APPROVED LAND CORNER
P.A. 345 of 1990
Gladwin County

Co. Rep. [Signature]
Date 12/14/95

Signed by Paul B. Lapham
Surveyor's Michigan License No. 9433

Date 12-22-95