

JAN 17 1996
COMMISSION

LAND CORNER RECORDATION CERTIFICATE
Filing Requirement of Act 74, Mich. P.A. 1970

LIBER 001 PAGE 82

For corners in

GLADWIN (County)	Located In:	Corner Code #
1. Public Land Survey	T 18N R 1W	G-12
	T R	
	T R	
	T R	
2. Property Controlling in Section	S T R	
	S T R	
3. Miscellaneous Property in Sec.	S T R	
	S T R	

STATE OF MICHIGAN
GLADWIN COUNTY
FILED-REMONUMENTATION

26 DEC 95 10:53 A.M.

BONNIE K. HOUSE
REGISTER OF DEEDS

Register of Deeds Stamp & File Number

4. Lot No. _____, Recorded Plat _____
5. Private Claims _____

I, PAUL B. LAPHAM, in a field survey on MAY-NOVEMBER, 19 95 do hereby state that under requirements of P.A. 74, Michigan P.A. of 1970, the corner points mentioned in lines 1 and 2 above were in conformance with regulations and rules therefore as required in the current manual of survey instructions of the United States Department of the Interior, Bureau of Land Management or by a decree of a Court of Law and /or that the corner points mentioned in lines 3, 4 and 5 above were in conformance with the rules of the Michigan Board of Land Surveyors or by a Decree of a Court of Law; established, re-established, monumented, recovered, found as expressed below:

NOTE: Not more than 2 corners, all in the same town and range, may be recorded on this certificate.

	A	B	C	D	E	F	G	H	I	J	K	L	M
1													
2	6		5		4		3		2		1		
3													
4	7		8		9		10		11		12		
5													
6	18		17		16		15		14		13		
7													
8	19		20		21		22		23		24		
9													
10	30		29		28		27		26		25		
11													
12	31		32		33		34		35		36		
13													

A. Description of original monument and accessories and/or subsequent restoration:


- 1877 T. GALE MERRILL SET POST WIT.-(1)HEMLOCK 18" N13°E 62 (2)HEMLOCK 8" S7°W 08
- 1976 PAUL LAPHAM, SURVEY #761064 WIT.-(3), (4) & (5)
- 1971 PAUL LAPHAM, SURVEY #1309 & WIT. NOTES
- 1977 PAUL LAPHAM, L.C.R.C. SET CAPPED IRON WIT.-SAME AS (3), (4) & (5)
- 1976 PAUL LAPHAM, SURVEY #760908 SET CAPPED IRON MIDWAY & ON LINE BETWEEN NW-SW COR'S WIT.-(3)S29°E 59.33' 12" PINE (4)S51°W 51.25' 12" PINE (5)N44°W 58.25' TRIPLE MAPLE
- 1992 PAUL LAPHAM, SURVEY G-923085 WIT.-SAME AS (3), (4) & (5)

B. Description of corner evidence found and/or method applied in restoring or reestablishing corner:

EXCAVATED 3' BELOW ASPHALT SURFACE FOUND 1/2" BAR, REMOVED & SET GLADWIN MONUMENT, FOUND WITNESSES (3) REC. 59.33', MEAS. 59.60', FOUND (4) MEAS. 51.29', REC. 51.25' MEAS. NORTH TO N.W. COR. SEC. 34 2642.45', REC. 2642.36', FOUND C.I. #9433

This Corner established in Gladwin County Remonumentation Program.

See dossier for detailed report.

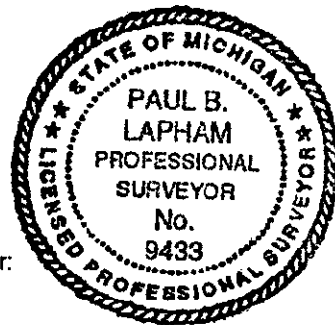

APPROVED LAND CORNER
P.A. 345 of 1990
Gladwin County

Co. Rep. [Signature]
Date 12/14/95

G-12: CORNER COMMON TO SECTIONS 33 & 34
SET 5/8"x36" RE-ROD WITH GLADWIN COUNTY RE-MON CAP MARKED P.S. #9433 IN MON. BOX.

- WITNESSES:
- S29°E 59.60' - NAIL & TAG IN 15" R. PINE
 - S51°W 51.25' - NAIL & TAG IN 15" R. PINE
 - N40°W 53.55' - NAIL & TAG IN TWIN MAPLE
 - N85°E 61.93' - NAIL & TAG IN 16" PINE
 - NORTH 2.0' P.K. NAIL
 - EAST 2.0' P.K. NAIL

Signed by Paul B. Lapham
Surveyor's Michigan License No. 9433

Date 12-22-95