

GLADWIN COUNTY REMONUMENTATION

LAND CORNER RECORDATION CERTIFICATE
Filing Requirement of Act 74, Mich. P.A. 1970

LIBER 001 PAGE 172

For corners in

<u>GLADWIN</u> (County)	Located In:	Corner Code #
1. Public Land Survey	T <u>18N</u> R <u>1W</u>	<u>H-3</u>
	T ___ R ___	_____
	T ___ R ___	_____
	T ___ R ___	_____
2. Property Controlling in Section	S ___ T ___ R ___	_____
	S ___ T ___ R ___	_____
3. Miscellaneous Property in Sec.	S ___ T ___ R ___	_____
	S ___ T ___ R ___	_____
4. Lot No. _____, Recorded Plat _____		
5. Private Claims _____		

STATE OF MICHIGAN
GLADWIN COUNTY
FILED -Remonumentation

17 OCT 97 1:19 P.M.

BONNIE K. HOUSE
REGISTER OF DEEDS

Register of Deeds Stamp & File Number

I, MARK R. ROBISON, in a field survey on April 17, 19 97 do hereby state that under requirements of P.A. 74, Michigan P.A. of 1970, the corner points mentioned in lines 1 and 2 above were in conformance with regulations and rules therefore as required in the current manual of survey instructions of the United States Department of the Interior, Bureau of Land Management or by a decree of a Court of Law and/or that the corner points mentioned in lines 3, 4 and 5 above were in conformance with the rules of the Michigan Board of Land Surveyors or by a Decree of a Court of Law, established, re-established, monumented, recovered, found as expressed below:

NOTE: Not more than 2 corners, all in the same town and range, may be recorded on this certificate.

	A	B	C	D	E	F	G	H	I	J	K	L	M
1													
2	6		5		4		3		2		1		
3								●					
4	7		8		9		10		11		12		
5													
6	18		17		16		15		14		13		
7													
8	19		20		21		22		23		24		
9													
10	30		29		28		27		26		25		
11													
12	31		32		33		34		35		36		
13													

A. Description of original monument and accessories and/or subsequent restoration:

1877 T. Gale Merrill Set Post Wit.-(1)S40E 8 links 2" Pine (2)N80W 9links 12" Beech	1988 Ledy L.C.R.C.#302 Found 1/2" iron Wit.-(6)SW 8" Ash 32.41' (7)SSW 10" Ash 45.05' (8)WNW 16" Maple 90.36'
1975 Lapham L.C.R.C.#106 Found 1/2" iron Wit.-(3)South 1.47' Corner Post (4)North 24.68 Corner Post (5)S45W 32.39' - 5" Ash	1995 Lapham Survey Wit.-same as (3),(4) & (5) Misc. Lapham--4 working drawings

APPROVED LAND CORNER
P.A. 915 of 1990
Gladwin County

Co. Rep. [Signature]
Date 9/25/97

B. Description of corner evidence found and/or method applied in restoring or reestablishing corner:

Found Corner Post (new) at East end of unimproved county road to West.
Set Gladwin County Re-mon from found witnesses (5),(6),(7) & (8).

See dossier for detailed report.

C. Description of monument for corner and accessories established to perpetuate locating the position of the corner:

H-3: Corner common to Sections 3 & 10
Set 5/8" x 36" rerod with Gladwin County Re-mon Cap, marked P.S.#27458


Witnesses:
S45W 6" Ash, nail, 32.41'
S15W 10" Ash, spike, 45.05'
N75W 18" Maple, spike, 90.36
N15E 8" R. Pine, nail & tag, 42.32
S10E 3/4" bar in 3' x 3 1/2' x 2' concrete slab 72.40'

SURVEY &
REMONUMENTATION

JAN 08 1998

SECTION

Signed by [Signature]
Surveyor's Michigan License No. 27458

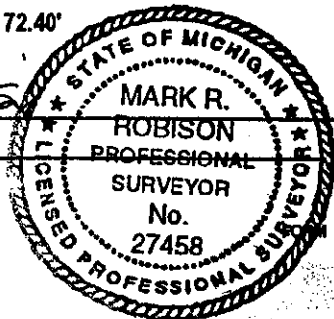

Date 10-7-97