

JAN 17 1996

COMMISSION

LAND CORNER RECORDATION CERTIFICATE
Filing Requirement of Act 74, Mich. P.A. 1970

LIBER 001 PAGE 83

STATE OF MICHIGAN
GLADWIN COUNTY
FILED-REMONUMENTATION

26 DEC 95 10:53 A.M.

BONNIE K. HOUSE
REGISTER OF DEEDS

For corners in

GLADWIN (County)	Located In:	Corner Code #
1. Public Land Survey	T 18NR 1W	H-11
	T R	
	T R	
	T R	
2. Property Controlling in Section	S T R	
	S T R	
3. Miscellaneous Property in Sec.	S T R	
	S T R	
4. Lot No. _____	Recorded Plat _____	
5. Private Claims _____		

Register of Deeds Stamp & File Number

	A	B	C	D	E	F	G	H	I	J	K	L	M
1													
2	6		5		4		3		2		1		
3													
4	7		8		9		10		11		12		
5													
6	18		17		16		15		14		13		
7													
8	19		20		21		22		23		24		
9													
10	30		29		28		27		26		25		
11													
12	31		32		33		34		35		36		
13													

I, PAUL B. LAPHAM, in a field survey on MAY-NOVEMBER, 1995 do hereby state that under requirements of P.A. 74, Michigan P.A. of 1970, the corner points mentioned in lines 1 and 2 above were in conformance with regulations and rules therefore as required in the current manual of survey instructions of the United States Department of the Interior, Bureau of Land Management or by a decree of a Court of Law and for that the corner points mentioned in lines 3, 4 and 5 above were in conformance with the rules of the Michigan Board of Land Surveyors or by a Decree of a Court of Law, established, re-established, monumented, recovered, found as expressed below:

NOTE: Not more than 2 corners, all in the same town and range, may be recorded on this certificate.

- A. Description of original monument and accessories and/or subsequent restoration:
- 1877 T. GALE MERRILL
WIT.-(1)PINE 26" FOR 1/4 SECTION POST
 - 1971 PAUL LAPHAM L.C.R.C. #27
FOUND 1 1/4" PIPE
WIT.-(3)N55°E 137.20' 6" MAPLE
(4)S71°W 138.20' 10" MAPLE
(5)S05°E 39.05' N.E. OF 3-3" MAPLES
 - 1971 PAUL LAPHAM SURVEY #1309
WIT. SAME AS L.C.R.C. #27
SURVEY & WORKING DWG.
 - 1982 PAUL LAPHAM, SURVEY #813640
WIT.-SAME AS L.C.R.C. #27
 - 1983 PAUL LAPHAM SURVEY #834761
FOUND 1/2" PIPE
WIT.-(6)N40°E FENCE POST 47.80'
(7)S45°W 5" MAPLE 74.00'
(8)SOUTH CLUMP MAPLE 38.80'
 - 1992 PAUL LAPHAM SURVEY,
SAME AS L.C.R.C. #27


- B. Description of corner evidence found and/or method applied in restoring or reestablishing corner:
- FOUND 1 1/4" PIPE 8" BELOW SURFACE IN C OF COUNTY ROAD, FOUND WITNESS # (5), MEAS. 38.80', REC. 39.05'
FOUND WITNESS # (8), REC. & MEAS. 38.80', REPLACE 1 1/4" PIPE WITH GLADWIN MONUMENT.

This Corner established in Gladwin County Remonumentation Program.
See dossier for detailed report.

- C. Description of monument for corner and accessories established to perpetuate locating the position of the corner:

H-11: 1/4 CORNER COMMON TO 27 & 34
SET 5/8" x 36" RE-ROD WITH GLADWIN COUNTY RE-MON CAP, MARKED P.S. #9433.

- WITNESSES:
- S03°E 38.80' - NAIL & TAG IN CLUMP MAPLE
 - S40°E 46.60' - NAIL & TAG IN POWER POLE
 - N40°E 64.60' - NAIL & TAG IN 8" SPRUCE
 - N35°W 122.72' - S.E. CORNER BLOCK FOUNDATION

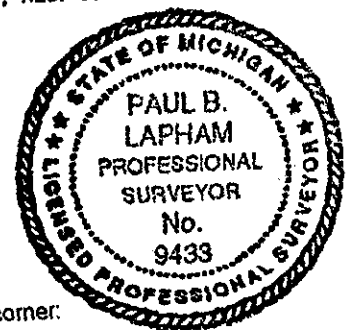

APPROVED LAND CORNER
P.A. 345 of 1990
Gladwin County

Co. Rep. [Signature]
Date 12/14/95

Signed by Paul B. Lapham
Surveyor's Michigan License No. 9433

Date 12-22-95