

JAN 17 1996

COMMISSION LAND CORNER RECORDATION CERTIFICATE
Filing Requirement of Act 74, Mich. P.A. 1970

For corners in

<u>GLADWIN</u> (County)	Located In:	Corner Code #
1. Public Land Survey	T <u>18N</u> R <u>1W</u>	<u>1-11</u>
	T <u> </u> R <u> </u>	<u> </u>
	T <u> </u> R <u> </u>	<u> </u>
	T <u> </u> R <u> </u>	<u> </u>
2. Property Controlling in Section	S <u> </u> T <u> </u> R <u> </u>	<u> </u>
	S <u> </u> T <u> </u> R <u> </u>	<u> </u>
3. Miscellaneous Property in Sec.	S <u> </u> T <u> </u> R <u> </u>	<u> </u>
	S <u> </u> T <u> </u> R <u> </u>	<u> </u>

LIBER **001** PAGE **84**

STATE OF MICHIGAN
GLADWIN COUNTY
FILED-REMONUMENTATION

26 DEC 95 10:53 A.M.

BONNIE K. HOUSE
REGISTER OF DEEDS

Register of Deeds Stamp & File Number

4. Lot No. _____, Recorded Plat _____
5. Private Claims _____

I, PAUL B. LAPHAM, in a field survey on MAY-NOVEMBER, 1995 do hereby state that under requirements of P.A. 74, Michigan P.A. of 1970, the corner points mentioned in lines 1 and 2 above were in conformance with regulations and rules therefore as required in the current manual of survey instructions of the United States Department of the Interior, Bureau of Land Management or by a decree of a Court of Law and/or that the corner points mentioned in lines 3, 4 and 5 above were in conformance with the rules of the Michigan Board of Land Surveyors or by a Decree of a Court of Law; established, re-established, monumented, recovered, found as expressed below:

NOTE: Not more than 2 corners, all in the same town and range, may be recorded on this certificate.

A	B	C	D	E	F	G	H	I	J	K	L	M
1												
2	6	5	4	3	2	1						
3												
4	7	8	9	10	11	12						
5												
6	18	17	16	15	14	13						
7												
8	19	20	21	22	23	24						
9												
10	30	29	28	27	26	25						
11												
12	31	32	33	34	35	36						
13												

- A. Description of original monument and accessories and/or subsequent restoration:
- 1877 T. GALE MERRILL
SET POST
WIT.-(1)PINE 28 S62°W 56'
(2)PINE 15 N11°E 18'
 - 1967 PAUL LAPHAM FIELD NOTES
FOUND OLD POST & 1" SQUARE IRON
WIT.-(3)S50°E 36.7' ROAD SIGN
(4)S70°E 61.2' 6" PINE
 - 1972 PAUL LAPHAM SURVEY
NO WITNESSES
 - 1972 SCHAFER L.C.R.C. #30
FOUND BUGGY AXLE 1" SQUARE STEEL
WIT.-(5)S45°E N&T IN T.P. 37.95'
(6)S50°W CENTER LINE 6" PINE 61.3'
(7)N40°E N&T P.P. 82.29'
 - 1974 PAUL LAPHAM L.C.R.C. #79
FOUND 1" BOLT RAISED WITH 1/2" IRON
WIT.-(8)S45°E 38.04' T.P.
(9)S28°W 111.01' POWER POLE
(10)N37°W 42.21' COR POST

1989 PAUL LAPHAM SURVEY
WIT. SAME AS L.C.R.C. #79
PAUL LAPHAM
WORKING DWG-NO WIT.

B. Description of corner evidence found and/or method applied in restoring or reestablishing corner:


FOUND 1/2" RE-ROD 0.5' BELOW SURFACE IN INTERSECTION OF CO. ROAD, EXCAVATED AND FOUND 3/4"x18" BOLT WITH SQUARE HEAD WITH WOOD STAKE 12" BELOW SURFACE OF ROAD, FOUND WIT. # (9), REC. & MEAS. 111.0', SET CORNER IN PLACE OF BOLT.

This Corner established in Gladwin County Remonumentation Program.
See dossier for detailed report.

C. Description of monument for corner and accessories established to perpetuate locating the position of the corner:

1-11: CORNER COMMON TO SECTIONS 26, 27, 34 & 35
SET 5/8"x36" RE-ROD WITH GLADWIN COUNTY RE-MON CAP, MARKED P.S. #9433.

WITNESSES:
S40°W 111.0' - SPIKE & CAP IN POWER POLE
S75°W 79.70' - NAIL & TAG IN 12" SPRUCE
N45°E 108.68' - NAIL & TAG IN 4" W. PINE
S45°E 87.37' - NAIL & TAG IN 12" MAPLE
NORTH P.K. NAIL 2.0'
EAST P.K. NAIL 2.0'

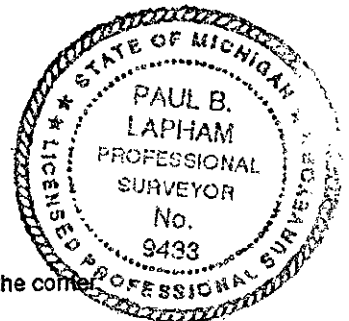

APPROVED LAND CORNER
P.A. 845 of 1990
Gladwin County

Co. Rep. J.H. Meyler
Date 12/14/95

Signed by Paul B. Lapham
Surveyor's Michigan License No. 9433

Date 12-22-95