

SURVEY & REMONUMENTATION
APR 07 1995
COMMISSION

LAND CORNER RECORDATION CERTIFICATE
Filing Requirement of Act 74, Mich. P.A. 1970

PAGE 53

STATE OF MICHIGAN
 GLADWIN COUNTY
 RECORDED

28 DEC 94 3:00 P.M.

BONNIE K. HOUSE
 REGISTER OF DEEDS

Register of Deeds Stamp & File Number

For corners GLADWIN (County) Located In: _____ Corner Code # _____

| | | |
|------------------------------------|--------------------------|------------|
| 1. Public Land Survey | T <u>18N</u> R <u>1W</u> | <u>L-9</u> |
| | T _____ R _____ | _____ |
| | T _____ R _____ | _____ |
| | T _____ R _____ | _____ |
| 2. Property Controlling in Section | S _____ T _____ R _____ | _____ |
| | S _____ T _____ R _____ | _____ |
| 3. Miscellaneous Property in Sec. | S _____ T _____ R _____ | _____ |
| | S _____ T _____ R _____ | _____ |

4. Lot No. _____, Recorded Plat _____

5. Private Claims _____

| | A | B | C | D | E | F | G | H | I | J | K | L | M |
|----|----|---|----|---|----|---|----|---|----|---|----|---|---|
| 2 | 6 | | 5 | | 4 | | 3 | | 2 | | 1 | | |
| 3 | | | | | | | | | | | | | |
| 4 | 7 | | 8 | | 9 | | 10 | | 11 | | 12 | | |
| 5 | | | | | | | | | | | | | |
| 6 | 18 | | 17 | | 16 | | 15 | | 14 | | 13 | | |
| 7 | | | | | | | | | | | | | |
| 8 | 19 | | 20 | | 21 | | 22 | | 23 | | 24 | | |
| 9 | | | | | | | | | | | | | |
| 10 | 30 | | 29 | | 28 | | 27 | | 26 | | 25 | | |
| 11 | | | | | | | | | | | | | |
| 12 | 31 | | 32 | | 33 | | 34 | | 35 | | 36 | | |
| 13 | | | | | | | | | | | | | |

I, PAUL B. LAPHAM, in a field survey on NOVEMBER, 19 94, do hereby certify that under requirements of P.A. 74, Michigan P.A. of 1970, the corner points mentioned in lines 1 and 2 above were in conformance with regulations and rules therefore as required in the current manual of survey instructions of the United States Department of the Interior, Bureau of Land Management or by a decree of a Court of Law and/or that the corner points mentioned in lines 3, 4 and 5 above were in conformance with the rules of the Michigan Board of Land Surveyors or by a Decree of a Court of Law; established, re-established, monumented, re-monumented, recovered, found as expressed below:

NOTE: Not more than 4 corners, all in the same town and range, may be recorded on this certificate.

A. Description of original monument and accessories and/or subsequent restoration:

- 1872 T. GALE MERRILL
 SET POST
 WIT.-MAPLE 15: N27°E 16
 HEMLOCK 13" S78°W 09
- 1982-1989 LAPHAM, SURVEY-#G-899352 & #G-855566 & #823736, WORKSHEET
- 1983 J. MEYERS, L.C.R.C. #288
 FOUND 1/2" IRON
 WIT.-N45°W STUD POLE 49.90'
 NORTH FENCE CORNER 32.95'
 S45°E POWER POLE 57.20'

APPROVED LAND CORNER
 P.A. 345 of 1990
 Gladwin County

Co. Rep. [Signature]
 Date 12-19-94

B. Description of corner evidence found and/or method applied in restoring or reestablishing corner:


FOUND 1/2"x18" RE-ROD IN C OF ROAD, 4"x4' OIL CASING PIPE & OLD FENCE TO NORTH, DIVIDING FIELD LINE & WOODS, 6" POST TO SOUTH, SEARCHED-NO OTHER CORNER EVIDENCE FOUND.
 N45°E STUD POLE 44.90' - MEAS. 44.90'
 S40°E POWER POLE 57.20' - MEAS. 57.10'
 SET CORNER IN FOUND 1/2" IRON LOCATION & WITNESSES

Accepted as best available evidence of the position of the original corner & replaced with Standard Monument.

Corner, L-9 was approved for remonumentation at a Peer Review Committee Meeting on 12/19, 19 94.

C. Description of monument for corner and accessories established to perpetuate locating the position of the corner:

L-9: Corner common to Sections 24 & 25
 SET 5/8"x36" RE-ROD WITH GLADWIN COUNTY RE-MON CAP, MARKED P.S. #9433.
 WITNESSES:
 N45°E ELECTRIC POLE STUD - NAIL & TAG - 44.80'
 S40°E POWER POLE - NAIL & TAG - 57.10'
 NORTH 4"x4' PIPE, FACE AT TOP 33.23'
 SOUTH 1/2"x36" RE-ROD 10' SOUTH FENCE POST 43.40'

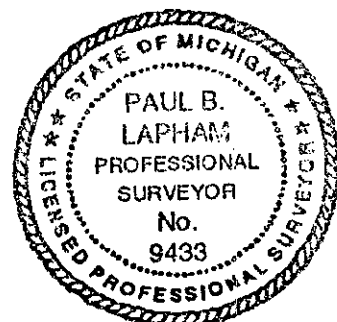

Signed by Paul B. Lapham Date 12-23-94
 Surveyor's Michigan License No. 9433