

SURVEY & REMONUMENTATION COMMISSION
 APR 07 1995
 For corners in GLADWIN (County)

LAND CORNER RECORDATION CERTIFICATE
 Filing Requirement of Act 74, Mich. P.A. 1970

	Located In:	Corner Code #
1. Public Land Survey	T <u>18N</u> R <u>1W</u>	<u>L-11</u>
	T _____ R _____	_____
	T _____ R _____	_____
	T _____ R _____	_____
2. Property Controlling in Section	S _____ T _____ R _____	_____
	S _____ T _____ R _____	_____
3. Miscellaneous Property in Sec.	S _____ T _____ R _____	_____
	S _____ T _____ R _____	_____

STATE OF MICHIGAN
 GLADWIN COUNTY
 RECORDED
 28 DEC 94 3:01 P.M.
 BONNIE K. HOUSE
 REGISTER OF DEEDS
 Register of Deeds Stamp & File Number

4. Lot No. _____, Recorded Plat _____
 5. Private Claims _____

I, PAUL B. LAPHAM, in a field survey on NOVEMBER, 19 94, do hereby certify that under requirements of P.A. 74, Michigan P.A. of 1970, the corner points mentioned in lines 1 and 2 above were in conformance with regulations and rules therefore as required in the current manual of survey instructions of the United States Department of the Interior, Bureau of Land Management or by a decree of a Court of Law and/or that the corner points mentioned in lines 3, 4 and 5 above were in conformance with the rules of the Michigan Board of Land Surveyors or by a Decree of a Court of Law, established, re-established, monumented, re-monumented, recovered, found as expressed below.

NOTE: Not more than 4 corners, all in the same town and range, may be recorded on this certificate.

	A	B	C	D	E	F	G	H	I	J	K	L	M
2	6	5	4	3	2								
3													
4	7	8	9	10	11	12							
5													
6	18	17	16	15	14	13							
7													
8	19	20	21	22	23	24							
9													
10	30	29	28	27	26	25							
11													
12	31	32	33	34	35	36							
13													

A. Description of original monument and accessories and/or subsequent restoration:
 1877 T. GALE MERRILL
 HEMLOCK 16 FOR QR SECTION POST
 1980 LAPHAM, WORKSHEET
 1990 LAPHAM, SURVEY #G-900037 & #G-922885
 FOUND 5/8" ROD SOUTH CENTER-LINE
 WIT.-NORTH 34.30' CORNER POST
 N45°E 73.40' POWER POLE
 S40°E 66.70' 24" OAK

APPROVED LAND CORNER
 P.A. 345 of 1990
 Gladwin County


Co. Rep. [Signature]
 Date 12-19-94

B. Description of corner evidence found and/or method applied in restoring or reestablishing corner:
 FOUND 5/8"x30" POINT WITH EYE, 4' SOUTH OF GRAVEL COUNTY ROAD. OLD FENCE NORTH & SOUTH.
 SEARCHED-FOUND NO OTHER EVIDENCE.
 NORTH 34.30' CORNER POST - NAIL & TAG - MEAS. 34.36'
 N45°E 73.40' POWER POLE - NAIL & TAG - MEAS. 73.85'
 S40°E 66.70' 24" OAK - NAIL & TAG - MEAS. 66.45'
 SET CORNER IN FOUND LOCATION OF 5/8" ROD & WITNESSES

Accepted as best available evidence of the position of the original corner & replaced with Standard Monument.

Corner, L-11 was approved for remonumentation at a Peer Review Committee Meeting on 12/19, 19 94.

C. Description of monument for corner and accessories established to perpetuate locating the position of the corner.
 L-11: Corner common to Sections 25 & 36
 SET 5/8"x36" RE-ROD WITH GLADWIN COUNTY RE-MON CAP, MARKED P.S. #9433.
 WITNESSES:
 NORTH CORNER POST - NAIL & TAG - 34.36'
 N45°E POWER POLE - NAIL & TAG - 73.85'
 S05°E 8" MAPLE - NAIL & TAG - 57.75'
 N25°E 4" W. PINE - NAIL & TAG - 59.10'

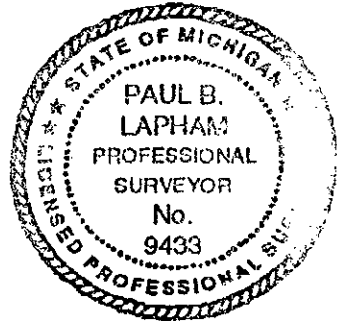

Signed by [Signature] Date 12-23-94
 Surveyor's Michigan License No. 9433