

SURVEY & MONUMENTATION
APR 07 1995
COMMISSION

LAND CORNER RECORDATION CERTIFICATE
Filing Requirement of Act 74, Mich. P.A. 1970

For corners:

_____	GLADWIN (County)	Located in:	Corner Code #
1. Public Land Survey	T <u>18N</u> R <u>1W</u>		<u>L-13</u>
	T _____ R _____		_____
	T _____ R _____		_____
	T _____ R _____		_____
2. Property Controlling in Section	S _____ T _____ R _____		_____
	S _____ T _____ R _____		_____
3. Miscellaneous Property in Sec.	S _____ T _____ R _____		_____
	S _____ T _____ R _____		_____
4. Lot No. _____, Recorded Plat _____			
5. Private Claims _____			

STATE OF MICHIGAN
 GLADWIN COUNTY
 RECORDED

28 DEC 94 3:01 P.M.

BONNIE K. HOUSE
 REGISTER OF DEEDS

Register of Deeds Stamp & File Number

I, PAUL B. LAPHAM, in a field survey on NOVEMBER, 19 94, do hereby certify that under requirements of P.A. 74, Michigan P.A. of 1970, the corner points mentioned in lines 1 and 2 above were in conformance with regulations and rules therefore as required in the current manual of survey instructions of the United States Department of the Interior, Bureau of Land Management or by a decree of a Court of Law and/or that the corner points mentioned in lines 3, 4 and 5 above were in conformance with the rules of the Michigan Board of Land Surveyors or by a Decree of a Court of Law; established, re-established, monumented, re-monumented, recovered, found as expressed below:

NOTE: Not more than 4 corners, all in the same town and range, may be recorded on this certificate.

	A	B	C	D	E	F	G	H	I	J	K	L	M
2	6	5	4	3	2	1							
3													
4	7	8	9	10	11	12							
5													
6	18	17	16	15	14	13							
7													
8	19	20	21	22	23	24							
9													
10	30	29	28	27	26	25							
11													
12	31	32	33	34	35	36							
13													

A. Description of original monument and accessories and/or subsequent restoration:

1887 T. GALE MERRILL
 SET 1/2 MILE POST
 WIT.-TAMARACK 7" N83°W 12'
 DO 5" N87°E 13'

1985 GRANGER
 SET CAPPED IRON
 WIT.-S53°W 61.39' POWER POLE
 S30°E 52.96' TELE. POLE
 NORTH 55.03' POWER POLE
 CENTER OF 8' WIDE BRIDGE 12' EAST OF COR.

1988 P.B.L., SEC. SUBDIVISION

APPROVED LAND CORNER
 P.A. 345 of 1990
 Gladwin County

Co. Rep. *Paul B. Lapham*
 Date 12-19-94

B. Description of corner evidence found and/or method applied in restoring or reestablishing corner:


FOUND 1/2"x8" RE-ROD WITH CAP 3' NORTH @ ROAD 12± W. CTR. BRIDGE.
 SEARCHED-FOUND NO OTHER CORNER EVIDENCE.
 S55°W POWER POLE 61.39'; MEAS. 61.43'
 NORTH POWER POLE 55.03', MEAS. 55.00'
 SET CORNER FROM FOUND 1/2" RE-ROD (R.L.S.) & GRANGER WITNESSES

Accepted as best available evidence of the position of the original corner & replaced with Standard Monument.

C. Description of monument for corner and accessories established to perpetuate locating the position of the corner:
 Corner, L-13 was approved for remonumentation at a Peer Review Committee Meeting on 12/19, 19 94.

L-13: Corner common to Section 36
 SET 5/8"x36" RE-ROD WITH GLADWIN COUNTY RE-MON CAP, MARKED P.S. #9433.

WITNESSES:
 S30°E NW CORNER HOUSE (FOUNDATION) 91.60'
 S61°W POWER POLE 61.43' - NAIL & TAG
 N05°W POWER POLE 55.00'
 N70°E POWER POLE 109.11'

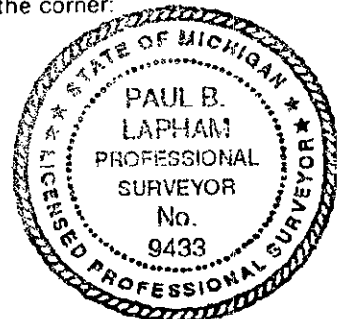

Signed by *Paul B. Lapham* Date 12-23-94
 Surveyor's Michigan License No. 9433