

AUG 23 2000

SECTION

LAND CORNER RECORDATION CERTIFICATE
Filing Requirement of Act 74, Mich. P.A. 1970
Gladwin County Remonumentation

LIBER 001 PAGE 318

For Corners in
GLADWIN

(County)

Located In:

Corner Code#:

- 1. Public Land Survey T. 18N R. 2W A-3
2. Public Controlling in Section S. T. R.
3. Miscellaneous Property in Section S. T. R.
4. Lot No. Recorded Plat
5. Private Claims

STATE OF MICHIGAN
GLADWIN COUNTY
FILED-REMONUMENTATION

10 AUG 2000 11:22:19 AM

BONNIE K. HOUSE
REGISTER OF DEEDS

Register of Deeds Stamp & File Number

I, Mark R. Robison, in a field survey on March 2000, do hereby certify that under requirements of P.A. 74, Michigan P.A. of 1970, the corner points mentioned in lines 1 and 2 above were in conformance with regulations and rules therefore as required in the current manual of survey instructions of the United States Department of the Interior, Bureau of Land Management or by a decree of a Court of Law and/or that the corner points mentioned in lines 3, 4 and 5 above were in conformance with the rules of the Michigan Board of Land Surveyors or by a Decree of a Court of Law, established, re-established, monumented, re-monumented, recovered, found as expressed below.

NOTE: Not more than 2 corners, all in the same town and range, may be recorded on this certificate.

Grid table with columns A-M and rows 1-13. Cell 2,6 contains '6', cell 2,5 contains '5', cell 2,4 contains '4', cell 2,3 contains '3', cell 2,2 contains '2', cell 2,1 contains '1'. Cell 4,1 contains '7', cell 4,2 contains '8', cell 4,3 contains '9', cell 4,4 contains '10', cell 4,5 contains '11', cell 4,6 contains '12'. Cell 6,1 contains '18', cell 6,2 contains '17', cell 6,3 contains '16', cell 6,4 contains '15', cell 6,5 contains '14', cell 6,6 contains '13'. Cell 8,1 contains '19', cell 8,2 contains '20', cell 8,3 contains '21', cell 8,4 contains '22', cell 8,5 contains '23', cell 8,6 contains '24'. Cell 10,1 contains '30', cell 10,2 contains '29', cell 10,3 contains '28', cell 10,4 contains '27', cell 10,5 contains '26', cell 10,6 contains '25'. Cell 12,1 contains '31', cell 12,2 contains '32', cell 12,3 contains '33', cell 12,4 contains '34', cell 12,5 contains '35', cell 12,6 contains '36'.

A. Description of original monument and accessories and/or subsequent restoration:

1838 Nicholson
Set Post Cor Sections 1 & 12
Wit-(1)Maple 15 S2W 61
(2)Pine 10 North 1 1/2

1972 Courtwright
LCRC#42-72
Found 5/8" Iron
Wit-(4)P.P., N45°W 39.79'
(5)Sign Pole, S45°W 36.02'
(6)P.P., S45°E 47.43'

1984 Lapham--LCRC#286
Found 5/8" S. Rod
Wit-(7)S45°W Brace Pole 44.77
(8)S30°E 8" Ash 68.65
(9)N50°E Sign Post 38.10

1903 A. Johnson
Wit-(3)Pine Stump S18W 160 (105.6)

1981 Lapham--working dwg
Found 5/8" Iron
Wit-none

B. Description of corner evidence found and/or method applied in restoring or re-establishing corner:

Found 5/8" x 18" rered over 3/4" iron & metal eye screw 24" below road surface 5 feet West and 5 feet North of road intersection. Agrees with witnesses (4)Recorded 39.79, measured 39.70' to face P.P. & (7)Recorded & measured to spike in Brace Pole 44.7'. Agrees within reason with A. Johnson (1903) measurement to A-2 2651.55' & Lapham (1972) 2654.50'. Accepted found 5/8" rered as corner of record; replaced with 5/8" x 36" rered. Did not remove 3/4" iron & metal eye screw.

See dossier for detailed report on corner A-3.

APPROVED LAND CORNER

P.A. 345 of 1990
Gladwin County


Co. Rep. [Signature]
Date 8-9-00

C. Description of monument for corner and accessories established to perpetuate locating the position of the corner:

Set 5/8" x 36" rered with Gladwin Remonumentation cap marked P.S. 27458. Accepted as best available evidence to perpetuate position of corner A-3.

Witnesses:

- N45°W Power Pole, spike, 40.20' (OBT)
N80°E Power Pole, nail & tag, 136.95'
S25°W 10" Ash, nail & tag, 101.40'
S55°W 5" Ash, nail & tag, 78.15'

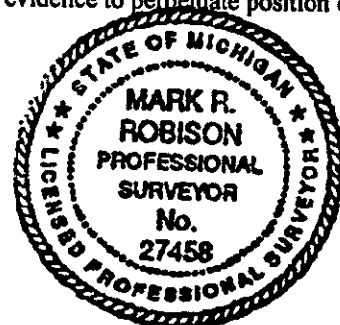

Signed by [Signature]
Surveyor's Michigan License No. 27458

Date 8-9-00