

AUG 23 2000

SECTION

LAND CORNER RECORDATION CERTIFICATE
Filing Requirement of Act 74, Mich. P.A. 1970
Gladwin County Remonumentation

LIBER 001 PAGE 313

For Corners in
GLADWIN
(County)

Located In: Corner Code#:

- 1. Public Land Survey T. 18N R. 2W A-10
T. _____ R. _____
T. _____ R. _____
- 2. Public Controlling in Section S. _____ T. _____ R. _____
S. _____ T. _____ R. _____
- 3. Miscellaneous Property in Section S. _____ T. _____ R. _____
S. _____ T. _____ R. _____
- 4. Lot No. _____, Recorded Plat _____
- 5. Private Claims _____

STATE OF MICHIGAN
GLADWIN COUNTY
FILED-REMONUMENTATION
10 AUG 2000 11:21:17 AM
BONNIE K. HOUSE
REGISTER OF DEEDS

Register of Deeds Stamp & File Number

I, Mark R. Robison, in a field survey on March 2000, do hereby certify that under requirements of P.A. 74, Michigan P.A. of 1970, the corner points mentioned in lines 1 and 2 above were in conformance with regulations and rules therefore as required in the current manual of survey instructions of the United States Department of the Interior, Bureau of Land Management or by a decree of a Court of Law and/or that the corner points mentioned in lines 3, 4 and 5 above were in conformance with the rules of the Michigan Board of Land Surveyors or by a Decree of a Court of Law, established, re-established, monumented, re-monumented, recovered, found as expressed below.

NOTE: Not more than 2 corners, all in the same town and range, may be recorded on this certificate.

	A	B	C	D	E	F	G	H	I	J	K	L	M
1													
2	6	5	4	3	2	1							
3													
4	7	8	9	10	11	12							
5													
6	18	17	16	15	14	13							
7													
8	19	20	21	22	23	24							
9													
10	30	29	28	27	26	25							
11													
12	31	32	33	34	35	36							
13													

A. Description of original monument and accessories and/or subsequent restoration:

1883 Nicholson--Set QR. Section Post
Wit-(1)Pine 28 N49W 19
(2)Elm 8 S66W 14

1968 Lapham
survey & field notes
Set 5/8" Iron in old Fence Cor, from
found O.B.T by Johnson

1908 Johnson
Wit-(3)W. Pine 20 N35W 40
(4)W. Pine 20 S75E 34 1/2

1979 Sedgman--LCRC#334-79
Found 5/8" Iron
Wit-(5)N30°W 32.34' 5" Maple
(6)S75°E 22.30' 6" Twin Maple
(7)S25°E 18.71' 4" Oak
(8)S80°W 41.97' 32" Oak

1979 Lapham --working dwg

APPROVED LAND CORNER
P.A. 345 of 1990
Gladwin County

Co. Rep. [Signature]
Date 8-9-00

B. Description of corner evidence found and/or method applied in restoring or re-establishing corner:


Found 5/8" x 18" iron in down pile of old fence posts at intersection of old fences from the West and South, approximately 300 feet North of Wolf Lake and 100 feet North of East-West Trail road. Agrees with witnesses from LCRC#334-79. Accepted found 5/8" iron as corner of record; replaced with 5/8" x 36" rerod.

See dossier for detailed report on corner A-10.

C. Description of monument for corner and accessories established to perpetuate locating the position of the corner:

Set 5/8" x 36" rerod with Gladwin Remonumentation cap marked P.S. 27458. Accepted as best available evidence to perpetuate position of corner A-10.

- Witnesses:
- N30°W 10" Maple, nail & tag, 32.05' (N.B.T)
 - S75°E 10" Twin Maple, nail & tag, 21.75'
 - S25°E 8" Oak, nail & tag, 19.05'
 - West 6" Maple, nail & tag, 15.25'

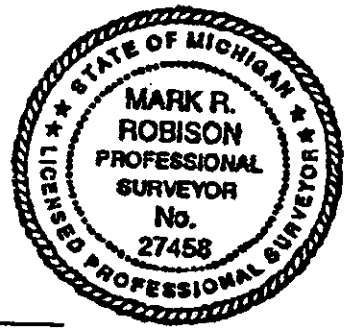

Signed by [Signature]
Surveyor's Michigan License No. 27458

Date 8-9-00