

AUG 23 2000

SECTION

LAND CORNER RECORDATION CERTIFICATE
Filing Requirement of Act 74, Mich. P.A. 1970
Gladwin County Remonumentation

LIBER 001 PAGE 294

For Corners in
GLADWIN

(County)

Located In:

Corner Code#:

- 1. Public Land Survey T. 18N R. 2W A-13
2. Public Controlling in Section S. T. R.
3. Miscellaneous Property in Section S. T. R.
4. Lot No., Recorded Plat
5. Private Claims

STATE OF MICHIGAN
GLADWIN COUNTY
FILED-REMONUMENTATION

10 AUG 2000 11:16:45 AM

BONNIE K. HOUSE
REGISTER OF DEEDS

Register of Deeds Stamp & File Number

I, Mark R. Robison, in a field survey on March 2000, do hereby certify that under requirements of P.A. 74, Michigan P.A. of 1970, the corner points mentioned in lines 1 and 2 above were in conformance with regulations and rules therefore as required in the current manual of survey instructions of the United States Department of the Interior, Bureau of Land Management or by a decree of a Court of Law and/or that the corner points mentioned in lines 3, 4 and 5 above were in conformance with the rules of the Michigan Board of Land Surveyors or by a Decree of a Court of Law, established, re-established, monumented, re-monumented, recovered, found as expressed below.

Grid table with columns A-M and rows 1-13 containing numbers 1-36.

NOTE: Not more than 2 corners, all in the same town and range, may be recorded on this certificate.

A. Description of original monument and accessories and/or subsequent restoration:

1831 R. Clark, intersected town cor.
T17&18N, R2&3W
Wit-(1)Pine 18 N41E 20
(2)Beech 6 S12E 25

1911 Johnson
Wit-(4)W. Pine 18 N41E 20 Gov't Tree
(5)W. Pine 36 N55°30W 38

1959 Lapham--survey
Wit-none

1986 Co. Rd. Plans, Fd 1" Iron
Wit-(6)North U. Pole 71.25
(7)N45E 91.55 SW Cor Hse
(8)S30W 136.6 U. Pole

1900 C.S.R. Gladwin
Set Oak Post 2x2x3 & Iron & Glass, in
stump of Pine
Wit-(3)Pine Stump 36" N55 1/2W 39L

1997 Lapham--survey notes
Fd 1" Iron
Wit-none

B. Description of corner evidence found and/or method applied in restoring or re-establishing corner:

Found 1" x 18" pipe over 3/4" x 24" iron bar in centerline of East-West road opposite centerline of long drive to the South. Agrees with Lapham survey (1959) and County Road witnesses (1986). Corner material is old and appears to have been in place for many years. Accepted found pipe and bar as corner of record; replaced with 5/8" x 36" rerod.

See dossier for detailed report on corner A-13.


APPROVED LAND CORNER
P.A. 345 of 1990
Gladwin County

Co. Rep. [Signature]
Date 6-2-00

C. Description of monument for corner and accessories established to perpetuate locating the position of the corner:

Set 5/8" x 36" rerod with Gladwin Remonumentation cap marked P.S. 27458. Accepted as best available evidence to perpetuate position of corner A-13.

Witnesses:
North U. Pole, spike, 72.25' (OBT)
N45°E SW Corner House, 91.55' (OBT)
S42°E 6" Ash, nail & tag, (NBT)
S30°W 48" stone, East side Base "x" 36.70'

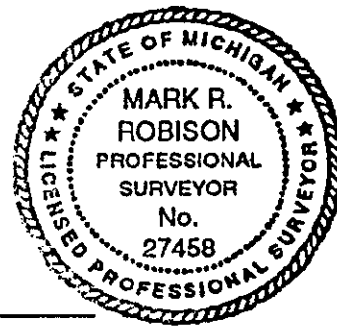

Signed by [Signature]
Surveyor's Michigan License No. 27458

Date 8-9-00