

**SURVEY &
REMONUMENTATION**

JAN 17 1996 LAND CORNER RECORDATION CERTIFICATE
Filing Requirement of Act 74, Mich. P.A. 1970

LIBER **001** PAGE **70**

For corners in

COMMISSION

<u>GLADWIN</u> (County)	Located In:	Corner Code #
1. Public Land Survey	<u>T18N R 2W</u>	<u>B-11</u>
	T <u> </u> R <u> </u>	<u> </u>
	T <u> </u> R <u> </u>	<u> </u>
	T <u> </u> R <u> </u>	<u> </u>
2. Property Controlling in Section	S <u> </u> T <u> </u> R <u> </u>	<u> </u>
	S <u> </u> T <u> </u> R <u> </u>	<u> </u>
3. Miscellaneous Property in Sec.	S <u> </u> T <u> </u> R <u> </u>	<u> </u>
	S <u> </u> T <u> </u> R <u> </u>	<u> </u>

STATE OF MICHIGAN
GLADWIN COUNTY
FILED-REMONUMENTATION

26 DEC 95 10:50 A.M.

BONNIE K. HOUSE
REGISTER OF DEEDS

Register of Deeds Stamp & File Number

4. Lot No. _____, Recorded Plat _____
5. Private Claims _____

I, PAUL B. LAPHAM, in a field survey on MAY-NOVEMBER, 1995 do hereby state that under requirements of P.A. 74, Michigan P.A. of 1970, the corner points mentioned in lines 1 and 2 above were in conformance with regulations and rules therefore as required in the current manual of survey instructions of the United States Department of the Interior, Bureau of Land Management or by a decree of a Court of Law and/or that the corner points mentioned in lines 3, 4 and 5 above were in conformance with the rules of the Michigan Board of Land Surveyors or by a Decree of a Court of Law, established, re-established, monumented, recovered, found as expressed below:

NOTE: Not more than 2 corners, all in the same town and range, may be recorded on this certificate.

1	A	B	C	D	E	F	G	H	I	J	K	L	M
2		6		5		4		3		2		1	
3													
4		7		8		9		10		11		12	
5													
6		18		17		16		15		14		13	
7													
8		19		20		21		22		23		24	
9													
10		30		29		28		27		26		25	
11		●											
12		31		32		33		34		35		36	
13													

A. Description of original monument and accessories and/or subsequent restoration:

1856 GEO H. CANNON
WIT.-(1)MAPLE 12" OLD GRAVEL ROAD
(2)HEMLOCK 15" S28°E 18

1979 LAPHAM SURVEY #782190
WIT.-SAME AS (4), (5) & (6)

1994 LAPHAM SURVEY #G-945541
WIT.-SAME AS (4), (5) & (6)

1900 COUNTY SURVEY RECORDS
SET CEDAR POST, OLD SAW
WIT.-(3)PINE STUMP 24" N2°E 51 LKS


1985 LAPHAM SURVEY #G-855552
WIT.-SAME AS (4), (5) & (6)

1971 LAPHAM L.C.R.C. & FIELD NOTES
SET 1/2" IRON OPPOSITE FENCE NORTH & SOUTH
WIT.-(4)N45°W 80.74' POWER POLE
(5)S45°E 38.77' TELE. POLE
(6)S10°E 121.45' 8" PINE

1991 LAPHAM UNRECORDED L.C.R.C. FOR
COUNTY ROAD CONSTRUCTION
FOUND 1/2" IRON
WIT.-(7)N45°W POWER POLE 80.70'
(8)S45°E POST & RISER 42.80'
(9)S35°E 8" W. PINE 51.00'
(10)S50°E 10" APPLE 69.55'

B. Description of corner evidence found and/or method applied in restoring or reestablishing corner:

FOUND 1/2" IRON IN CENTER-LINE GRAVEL ROAD, FENCE TO SOUTH, EXCAVATED NO OTHER CORNER FOUND
SET GLADWIN RE-MON FROM WITNESSES (7), (8), (9) & (10) MATCH WITNESSES (4), FOUND IRON 33' NORTH

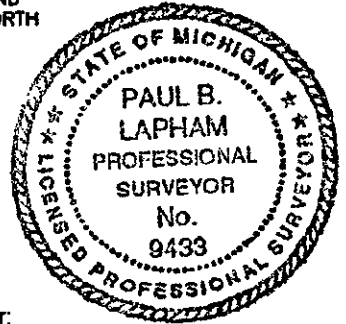

This Corner established in Gladwin County Remonumentation Program.

See dossier for detailed report.

C. Description of monument for corner and accessories established to perpetuate locating the position of the corner:

B-11: 1/4 CORNER COMMON TO SECTIONS 30 & 31
SET 5/8"x36" RE-ROD WITH GLADWIN COUNTY RE-MON CAP, MARKED P.S. #9433.

WITNESSES:
N45°W 80.70' - NAIL & TAG IN POWER POLE
S45°E 42.80' - NAIL & TAG IN POST & RISER
N35°E 51.00' - 8" W. PINE
S50°E 69.55' - 10" APPLE

APPROVED LAND CORNER
P.A. 345 of 1990
Gladwin County

Co. Rep. J. L. Meyer
Date 10/14/95

Signed by Paul B. Lapham
Surveyor's Michigan License No. 9433

Date 12-22-95