

JAN 17 1996

LAND CORNER RECORDATION CERTIFICATE
COMMISSION Filing Requirement of Act 74, Mich. P.A. 1970

STATE OF MICHIGAN
GLADWIN COUNTY
FILED-REMONUMENTATION

26 DEC 95 10:48 A.M.

RONNIE K. HOUSE
REGISTER OF DEEDS

For corners in

GLADWIN (County)	Located In:	Corner Code #
1. Public Land Survey	T 18N R 2W	I-10
	T R	
	T R	
	T R	
2. Property Controlling in Section	S T R	
	S T R	
3. Miscellaneous Property in Sec.	S T R	
	S T R	

Register of Deeds Stamp & File Number

4. Lot No. _____, Recorded Plat _____
5. Private Claims _____

I, PAUL B. LAPHAM, in a field survey on MAY-NOVEMBER, 19 95 do hereby state that under requirements of P.A. 74, Michigan P.A. of 1970, the corner points mentioned in lines 1 and 2 above were in conformance with regulations and rules therefore as required in the current manual of survey instructions of the United States Department of the Interior, Bureau of Land Management or by a decree of a Court of Law and/or that the corner points mentioned in lines 3, 4 and 5 above were in conformance with the rules of the Michigan Board of Land Surveyors or by a Decree of a Court of Law; established, re-established, monumented, recovered, found as expressed below:

	A	B	C	D	E	F	G	H	I	J	K	L	M
1													
2	6		5		4		3		2		1		
3													
4	7		8		9		10		11		12		
5													
6	18		17		16		15		14		13		
7													
8	19		20		21		22		23		24		
9													
10	30		29		28		27	●	26		25		
11													
12	31		32		33		34		35		36		
13													


NOTE: Not more than 2 corners, all in the same town and range, may be recorded on this certificate.

A. Description of original monument and accessories and/or subsequent restoration:

- 1856 GEO H. CANNON
OLD 1/4 SECTION COR.
SET POST
WIT.-(1)ELM 16" N77°E 12
(2)ELM 15" S22°W 11
- 1992 LAPHAM UNRECORDED L.C.R.C. FOR COUNTY ROAD CONSTRUCTION
FOUND 1/2" IRON AS RECORDED IN #232
WIT.-(6)N75°W 6" ASH N&T 30.70'
(7)S60°E P.P. N&T 42.55'
(8)N40°E 24" ASH N&T 76.30'
(9)EAST COR. POST N&T 29.19'
- 1979 LAPHAM L.C.R.C. #232 & WORKING DWG. & NOTES
SET 1/2" BAR R.L.S. IN CENTER OF ROAD OPPOSITE E-W FENCE
WIT.-(3)S20°W 56.33' 8" ASH
(4)WEST 22.04' 3" ASH
(5)EAST 29.19' COR. FENCE POST

B. Description of corner evidence found and/or method applied in restoring or reestablishing corner:

FOUND 1/2" IRON IN CENTER LINE OF ROAD OPPOSITE FENCE'S EAST AND WEST, EXCAVATED NO OTHER CORNERS FOUND.
SET GLADWIN RE-MON FROM EXISTING CORNER AND WITNESS (7), (8) & (5)

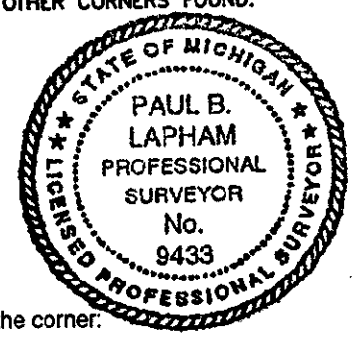

This Corner established in Gladwin County Remonumentation Program.
See dossier for detailed report.

C. Description of monument for corner and accessories established to perpetuate locating the position of the corner:

I-10: CORNER COMMON TO SECTIONS 26 & 27
SET 5/8"x36" RE-ROD WITH GLADWIN COUNTY RE-MON CAP, MARKED P.S. #9433.

- WITNESSES:
- S60°E 42.57' - NAIL & TAG IN POWER POLE
 - N40°E 76.40' - NAIL & TAG IN 24" ASH
 - EAST 32.47' - NAIL & TAG IN CORNER POST
 - N40°W 44.90' - 5/8"x36" RE-ROD

APPROVED LAND CORNER
P.A. 345 of 1990
Gladwin County

Co. Rep. [Signature]
Date 12/14/95

Signed by Paul B. Lapham
Surveyor's Michigan License No. 9433

Date 12-22-95