

JAN 17 1996  
LAND CORNER RECORDATION CERTIFICATE  
Filing Requirement of Act 74, Mich. P.A. 1970  
COMMISSION

LIBER 001 PAGE 62

For corners in

GLADWIN (County)	Located In:	Corner Code #
1. Public Land Survey	T 18N R 2W	I-12
	T R	
	T R	
	T R	
2. Property Controlling in Section	S T R	
	S T R	
3. Miscellaneous Property in Sec.	S T R	
	S T R	

STATE OF MICHIGAN  
GLADWIN COUNTY  
FILED-REMONUMENTATION

26 DEC 95 10:48 A.M.

RONNIE K. HOUSE  
REGISTER OF DEEDS

Register of Deeds Stamp & File Number

4. Lot No. \_\_\_\_\_, Recorded Plat \_\_\_\_\_  
5. Private Claims \_\_\_\_\_

I, PAUL B. LAPHAM, in a field survey on MAY-NOVEMBER, 19 95 do hereby state that under requirements of P.A. 74, Michigan P.A. of 1970, the corner points mentioned in lines 1 and 2 above were in conformance with regulations and rules therefore as required in the current manual of survey instructions of the United States Department of the Interior, Bureau of Land Management or by a decree of a Court of Law and/or that the corner points mentioned in lines 3, 4 and 5 above were in conformance with the rules of the Michigan Board of Land Surveyors or by a Decree of a Court of Law; established, re-established, monumented, recovered, found as expressed below:

	A	B	C	D	E	F	G	H	I	J	K	L	M
1													
2	6		5		4		3		2		1		
3													
4	7		8		9		10		11		12		
5													
6	18		17		16		15		14		13		
7													
8	19		20		21		22		23		24		
9													
10	30		29		28		27		26		25		
11													
12	31		32		33		34		35		36		
13													

NOTE: Not more than 2 corners, all in the same town and range, may be recorded on this certificate.

A. Description of original monument and accessories and/or subsequent restoration:

1856 GEO H. CANNON  
WIT.-(1) ASPEN OLD CORNER  
(2) W. PINE 7" S60°W 35  
(3) W. PINE 22" N55°E 41

1910 COUNTY SURVEY RECORD (KNOX)  
NO WITNESSES

1960 EDMANDS WORKING DWG & WITNESSES  
WIT.-(4) SET IRON W'LY 24' TO CORNER  
FENCE POST

1971 EDMANDS SURVEY  
FOUND IRON  
WIT.-SAME AS (4)

1971 COURTRIGHT SURVEY  
NO WITNESSES


1986 LAPHAM SURVEY #G-866877  
FOUND IRON  
WIT.-SAME AS (4)

1990 LAPHAM SURVEY #G-900116  
FOUND 1/2" IRON  
WIT.-(5) N40°E 45.10' 8" POPLAR  
(6) N40°E 49.35' 8" POPLAR  
(7) N85°W 26.75' FENCE POST

1992 LAPHAM UNRECORDED L.C.R.C.  
FOUND IRON  
WIT.-(8) S50°E TOP CENTER 16" C.M.P. N&T 36.22'  
(9) N50°E TOP CENTER 16" C.M.P. N&T 36.75'  
(10) WEST POWER POLE N&T 43.07'  
(11) N35°W FENCE POST N&T 57.78'  
LAPHAM MISC. WORKING DWG'S.

B. Description of corner evidence found and/or method applied in restoring or reestablishing corner:

FOUND 3/8"x18" IRON, WITH RUST BALL (OLD) IN CENTER LINE ROAD, MATCHED WITNESSES (8), (9), (10), (11) & (7) SET GLADWIN RE-MON FROM FOUND IRON & WITNESSES

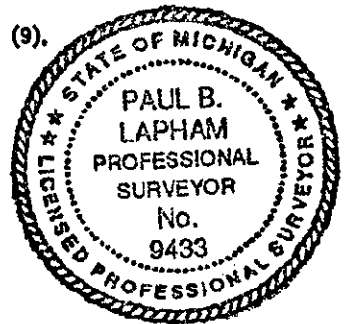

This Corner established in Gladwin County Remonumentation Program.

See dossier for detailed report.

C. Description of monument for corner and accessories established to perpetuate locating the position of the corner:

I-12: CORNER COMMON TO SECTIONS 34 & 35  
SET 5/8"x36" RE-ROD WITH GLADWIN COUNTY RE-MON CAP, MARKED P.S. #9433.

WITNESSES:  
S50°E 36.26' - NAIL & TAG IN TOP CENTER 16" C.M.P.  
N50°E 36.73' - NAIL & TAG IN TOP CENTER 16" C.M.P.  
WEST 43.00' - NAIL & TAG IN POWER POLE  
N35°W 57.76' - NAIL & TAG IN FENCE POST

APPROVED LAND CORNER  
P.A. 345 of 1990  
Gladwin County

Co. Rep. [Signature]  
Date 12/19/95

Signed by Paul B. Lapham  
Surveyor's Michigan License No. 9433

Date 12-27-95