

**SURVEY & REMONUMENTATION**

DEC 01 1999

**LAND CORNER RECORDATION CERTIFICATE**  
**Filing Requirement of Act 74, Mich. P.A. 1970**  
**Gladwin County Remonumentation**

LIBER **001** PAGE **274**

SECTION

For Corners in  
GLADWIN

(County)

Located In: Corner Code#:

- 1. Public Land Survey T. 18N R. 02W K-2  
 T. \_\_\_\_\_ R. \_\_\_\_\_  
 T. \_\_\_\_\_ R. \_\_\_\_\_
- 2. Public Controlling S. \_\_\_\_\_ T. \_\_\_\_\_ R. \_\_\_\_\_  
 in Section S. \_\_\_\_\_ T. \_\_\_\_\_ R. \_\_\_\_\_
- 3. Miscellaneous S. \_\_\_\_\_ T. \_\_\_\_\_ R. \_\_\_\_\_  
 Property in Section S. \_\_\_\_\_ T. \_\_\_\_\_ R. \_\_\_\_\_
- 4. Lot No. \_\_\_\_\_, Recorded Plat \_\_\_\_\_
- 5. Private Claims \_\_\_\_\_

STATE OF MICHIGAN  
 GLADWIN COUNTY  
 FILED-REMONUMENTATION

19 NOV 1999 2:02:28 PM

BONNIE K. HOUSE  
 REGISTER OF DEEDS

Register of Deeds Stamp & File Number

I, Mark R. Robison, in a field survey on July 1998, do hereby certify that under requirements of P.A. 74, Michigan P.A. of 1970, the corner points mentioned in lines 1 and 2 above were in conformance with regulations and rules therefore as required in the current manual of survey instructions of the United States Department of the Interior, Bureau of Land Management or by a decree of a Court of Law and/or that the corner points mentioned in lines 3, 4 and 5 above were in conformance with the rules of the Michigan Board of Land Surveyors or by a Decree of a Court of Law, established, re-established, monumented, re-monumented, recovered, found as expressed below.

NOTE: Not more than 2 corners, all in the same town and range, may be recorded on this certificate.

	A	B	C	D	E	F	G	H	I	J	K	L	M
2	6	5	4	3	2	1							
3													
4	7	8	9	10	11	12							
5													
6	18	17	16	15	14	13							
7													
8	19	20	21	22	23	24							
9													
10	30	29	28	27	26	25							
11													
12	31	32	33	34	35	36							
13													

A. Description of original monument and accessories and/or subsequent restoration:

- 1856 Geo H. Cannon 1973 Radcliffe  
 LCRC#82 & survey  
 Reset 1/2" Iron from  
 MDSH maps  
 Wit-(6)T.P. N25W 43.22  
 (7)Fe. Post North 69.94  
 (8)Center F. Hyd N10E 37.55
- 1938 MSHD field notes & road plans  
 Axle shaft in 4"sq. cedar post.  
 1/4 Cor is 2.2' N of POT  
 Natural Witnesses to 1/4 Corner  
 Wit-(3)N3°03'W Tel Pole 25.2'  
 (4)N46°30'W Tel Pole 34.83'  
 (5)S41°00'E 24" Elm 50.5'
- 1978-88 Lapham 5 surveys  
 Wit-same as (6), (7) & (8)
- 1988 Ledy survey  
 Wit-same as (6), (7) & (8)

- 1996-97 Lapham 3 surveys  
 Wit-same as (8)  
 (9)South 6.0 Centerline of Hwy  
 (10)N20W 42.95 Power Pole

1998 MDOT Found 1/2" Iron  
 See MDOT Plans#26011 for Loc & Wits

Corner Agrees with Plats of:

- 1962 Plat of Gladwin Heights Subd No 1
- 1970 Plat of Knob Hill
- 1956 Plat of Wood's Subd

B. Description of corner evidence found and/or method applied in restoring or re-establishing corner:

Found 1/2" Iron 2 feet West of centerline M-18 South & 6 feet West of centerline M-61. Iron agrees with witnesses (6) & (7). Also agrees with Plat of Gladwin Heights point of beginning.

See dossier for detailed report.

APPROVED LAND CORNER  
 P.A. 345 of 1990  
 Gladwin County

Co. Rep. John McManis  
 Date 10/30/98


C. Description of monument for corner and accessories established to perpetuate locating the position of the corner:

K-2: 1/4 Corner common to Sections 1 & 2. Set 5/8" x 18" rered in Monument Box with Gladwin County Remonumentation Cap marked P.S.#27458.

Witnesses:

- N35°E SE Corner Building, top of 2nd Brick, 79.68' (MDOT)
- N25°W Power Pole, DBL nail, 43.23' (MDOT)
- North Fence Post, DBL nail, 69.92' (MDOT)
- S45°E Power Pole, nail & tag, 76.89' (MDOT)

- S25°W GPS Mon, center disk, 119.46' (MDOT)
- N45°E, P.K. nail in curb, 59.47'
- North, CI#9433, 68.85'

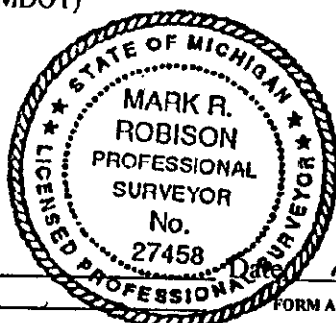

Signed by Mark R. Robison  
 Surveyor's Michigan License No. 27458