

SURVEY & REMONUMENTATION

DEC 01 1999

SECTION

LAND CORNER RECORDATION CERTIFICATE

**Filing Requirement of Act 74, Mich. P.A. 1970
Gladwin County Remonumentation**

LIBER 001 PAGE 279

For Corners in
GLADWIN

(County)

Located In:

Corner Code#:

- 1. Public Land Survey T. 18N R. 02W K-7
T. _____ R. _____
T. _____ R. _____
- 2. Public Controlling S. _____ T. _____ R. _____
in Section S. _____ T. _____ R. _____
- 3. Miscellaneous S. _____ T. _____ R. _____
Property in Section S. _____ T. _____ R. _____
- 4. Lot No. _____, Recorded Plat _____
- 5. Private Claims _____

STATE OF MICHIGAN
GLADWIN COUNTY
FILED-REMONUMENTATION

19 NOV 1999 2:03:32 PM

BONNIE K. HOUSE
REGISTER OF DEEDS

Register of Deeds Stamp & File Number

I, Mark R. Robison, in a field survey on April 1998, do hereby certify that under requirements of P.A. 74, Michigan P.A. of 1970, the corner points mentioned in lines 1 and 2 above were in conformance with regulations and rules therefore as required in the current manual of survey instructions of the United States Department of the Interior, Bureau of Land Management or by a decree of a Court of Law and/or that the corner points mentioned in lines 3, 4 and 5 above were in conformance with the rules of the Michigan Board of Land Surveyors or by a Decree of a Court of Law, established, re-established, monumented, re-monumented, recovered, found as expressed below.

NOTE: Not more than 2 corners, all in the same town and range, may be recorded on this certificate.

	A	B	C	D	E	F	G	H	I	J	K	L	M
1													
2	6	5	4	3	2	1							
3													
4	7	8	9	10	11	12							
5													
6	18	17	16	15	14	13							
7													
8	19	20	21	22	23	24							
9													
10	30	29	28	27	26	25							
11													
12	31	32	33	34	35	36							
13													

A. Description of original monument and accessories and/or subsequent restoration:

1856 Geo H. Cannon
Set Post Old Cor of Sec's 13,14,23&24
Wit-(1)Cedar 11 S63E 35
(2)Do 11 N62E 15

1956 Moore
Wit-(6)14" Oak S43E 47.9
(7)Oak S42W 27.8

1938 MSHD field notes & road plans
Approx Sec Cor Common to
Sec's 13, 14, 23, 24
Axle Shaft

1975 Lapham LCRC#117 & work dwg
Set 1/2" rerod Capped from MSHD data
Wit-(8)East 12.55 C/L M-18
(9)East 92.4 C/L North R/W Mon
(10)S80W 70.13 Fence Cor

Wit-(3)S62W Fe Cor Post 55.65
(4)N30E Fe Post 69.55
(5)East Fe Cor Post 50.25

1986 Lapham 4 surveys & work dwg
Found capped Iron
Wit-(8), (9) & (10)

1998 MDOT Found Iron w/cap#14409
See MDOT Plans#26011 for Loc & Wits

B. Description of corner evidence found and/or method applied in restoring or re-establishing corner:

Found Capped Iron, No.14099, 12 feet+/- West of centerline M-18, 18 feet +/- North of Fence Corner and Fence to West, and opposite old fence to East. Iron agrees with witnesses (8) & (10). It also agrees with MSHD (1938), Lapham (1975), and MDOT (1998) measurements to K-6 and K-8.

See dossier for detailed report.

**APPROVED LAND CORNER
P.A. 345 of 1990
Gladwin County**


Co. Rep. [Signature]
Date 10/30/98

C. Description of monument for corner and accessories established to perpetuate locating the position of the corner:

K-7: Corner common to Sections 13, 14, 23 & 24. Set 5/8" x 36" rerod with Gladwin County Remonumentation cap marked P.S.#27458.

Witnesses:

- N15°E Center East Leg Highway Sign 145.17' (MDOT)
- N10°W Center East Leg Highway Sign 138.44' (MDOT)
- S80°W Fence Corner, nail & tag, 70.55'
- S55°E 14" Elm, nail & tag, 127.25'
- N85°E 8" Willow, nail & tag, 107.00'
- N45°W 1/2" Rerod in Fence 95.00'

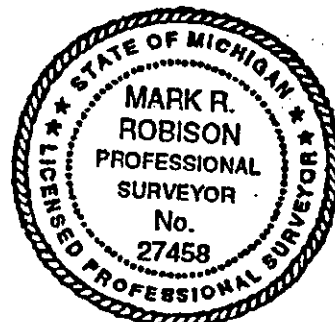

Signed by [Signature]
Surveyor's Michigan License No. 27458

Date 11-16-99