

SURVEY & REMONUMENTATION

DEC 01 1999

LAND CORNER RECORDATION CERTIFICATE
Filing Requirement of Act 74, Mich. P.A. 1970
Gladwin County Remonumentation

LIBER **001** PAGE **281**

SECTION

For Corners in
GLADWIN

(County)	Located In:	Corner Code#:
1. Public Land Survey	T. <u>18N</u> R. <u>02W</u>	<u>K-9</u>
	T. _____ R. _____	_____
	T. _____ R. _____	_____
2. Public Controlling in Section	S. _____ T. _____ R. _____	_____
	S. _____ T. _____ R. _____	_____
3. Miscellaneous Property in Section	S. _____ T. _____ R. _____	_____
	S. _____ T. _____ R. _____	_____
4. Lot No. _____, Recorded Plat _____		
5. Private Claims _____		

STATE OF MICHIGAN
 GLADWIN COUNTY
 FILED-REMONUMENTATION
 19 NOV 1999 2:04:02 PM
 BONNIE K. HOUSE
 REGISTER OF DEEDS
Register of Deeds Stamp & File Number

I, Mark R. Robison, in a field survey on April 1998, do hereby certify that under requirements of P.A. 74, Michigan P.A. of 1970, the corner points mentioned in lines 1 and 2 above were in conformance with regulations and rules therefore as required in the current manual of survey instructions of the United States Department of the Interior, Bureau of Land Management or by a decree of a Court of Law and/or that the corner points mentioned in lines 3, 4 and 5 above were in conformance with the rules of the Michigan Board of Land Surveyors or by a Decree of a Court of Law, established, re-established, monumented, re-monumented, recovered, found as expressed below.

	A	B	C	D	E	F	G	H	I	J	K	L	M
2	6	5	4	3	2	1							
3													
4	7	8	9	10	11	12							
5													
6	18	17	16	15	14	13							
7													
8	19	20	21	22	23	24							
9													
10	30	29	28	27	26	25							
11													
12	31	32	33	34	35	36							
13													

NOTE: Not more than 2 corners, all in the same town and range, may be recorded on this certificate.

A. Description of original monument and accessories and/or subsequent restoration:

- | | | |
|--|--|--|
| 1856 Geo H. Cannon Set Post
Old Cor of Sec's 23, 24, 25 & 26
Wit-(1)Hemlock 12 S28E 39
(2)W. Ash 12 N15W 6 1/2 | 1973 Lapham survey
Fd Mon Box in East
Edge of Road | 1978-97 Lapham 6 surveys
Wit-same as (6), (7) & (8) |
| 1938 MSHD field notes & road plans
Axle in 4" Sq. Wood Stake
Wit-(3)N44W 10" Elm 51.67
(4)N16E 12" Elm 96.00
(5)N48E 10" Elm 35.85 | 1973-97 Lapham working dwgs | 1998 MDOT Found 2" Bar in Mon Box
See MDOT Plans#26011 for Loc & Wits |
| 1960+/- Edmands Eng.
Work dwg & notes
Wit-same as (3), (4) & (5) | 1975 Lapham LCRC#117 & work dwg
Fd Mon Box
Wit-(6)S45W 72.95 NE Cor R/W Mon
(7)S40E 40.7' Iron in C/L Project
Marker
(8)S35W 64.05 P.P. | |

B. Description of corner evidence found and/or method applied in restoring or re-establishing corner:

Found 2" Bar in Monument Box 10 feet East of centerline M-18 and centerline of road to West. Bar agrees with Witnesses (7) & (8). Also agrees with MSHD (1938), Lapham (1975), and MDOT (1998) measurement to K-8.


See dossier for detailed report.

APPROVED LAND CORNER
 P.A. 345 of 1990
 Gladwin County
 Co. Rep. [Signature]
 Date 10-30-98

C. Description of monument for corner and accessories established to perpetuate locating the position of the corner:

K-9: Corner common to Sections 23, 24, 25 & 26. Set 5/8" x 18" rered in Monument Box with Gladwin County Remonumentation cap marked P.S.#27458.

- Witnesses:
 S60°W Power Pole, nail & tag, 64.08' (MDOT)
 N35°W NE Corner Building 135.32' (MDOT)
 S40°E Top Center Project Marker 40.92' (MDOT)
 West, P.K. Nail, Centerline Bituminous Surface 93.29'
 S60°E Power Pole, nail & tag, 98.85'
 N60°W 14" Pine, nail & tag, 151.3'

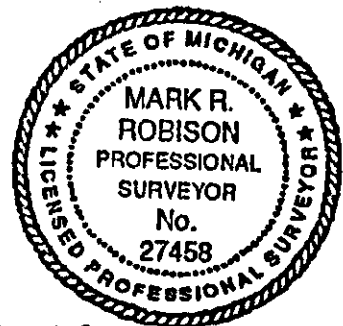

Signed by Mark R. Robison Date 11-16-99
 Surveyor's Michigan License No. 27458