

**SURVEY &  
REMONUMENTATION**

DEC 01 1999

**LAND CORNER RECORDATION CERTIFICATE**  
Filing Requirement of Act 74, Mich. P.A. 1970  
Gladwin County Remonumentation

LIBER 001 PAGE 284

SECTION

For Corners in

GLADWIN

(County)

Located In:

Corner Code#:

- 1. Public Land Survey T. 18N R. 02W K-12  
T. \_\_\_\_\_ R. \_\_\_\_\_  
T. \_\_\_\_\_ R. \_\_\_\_\_
- 2. Public Controlling S. \_\_\_\_\_ T. \_\_\_\_\_ R. \_\_\_\_\_  
in Section S. \_\_\_\_\_ T. \_\_\_\_\_ R. \_\_\_\_\_
- 3. Miscellaneous S. \_\_\_\_\_ T. \_\_\_\_\_ R. \_\_\_\_\_  
Property in Section S. \_\_\_\_\_ T. \_\_\_\_\_ R. \_\_\_\_\_
- 4. Lot No. \_\_\_\_\_, Recorded Plat \_\_\_\_\_
- 5. Private Claims \_\_\_\_\_

STATE OF MICHIGAN  
GLADWIN COUNTY  
FILED-REMONUMENTATION

19 NOV 1999 2:04:45 PM

RONNIE K. HOUSE  
REGISTER OF DEEDS

Register of Deeds Stamp & File Number

I, Mark R. Robison, in a field survey on April 1998, do hereby certify that under requirements of P.A. 74, Michigan P.A. of 1970, the corner points mentioned in lines 1 and 2 above were in conformance with regulations and rules therefore as required in the current manual of survey instructions of the United States Department of the Interior, Bureau of Land Management or by a decree of a Court of Law and/or that the corner points mentioned in lines 3, 4 and 5 above were in conformance with the rules of the Michigan Board of Land Surveyors or by a Decree of a Court of Law, established, re-established, monumented, re-monumented, recovered, found as expressed below.

NOTE: Not more than 2 corners, all in the same town and range, may be recorded on this certificate.

	A	B	C	D	E	F	G	H	I	J	K	L	M
1													
2	6	5	4	3	2	1							
3													
4	7	8	9	10	11	12							
5													
6	18	17	16	15	14	13							
7													
8	19	20	21	22	23	24							
9													
10	30	29	28	27	26	25							
11													
12	31	32	33	34	35	36							
13													

**A. Description of original monument and accessories and/or subsequent restoration:**

- 1856 Geo H. Cannon 1976 Lapham  
LCRC#151 & survey  
Set cap in hole in C/L M-18
- 1938 MSHD field notes & road plans 1977 Lapham Set P.K. Nail  
Axle Shaft 12" spike on centerline Wit-(14)N45E 76.53 16" Willow  
Wit-(3)N55W 24.79 SE Cor Culv (15)N55E 66.00 Top Cen Hwy Mon  
Headwall (16)N45W 38.15 NW Cor Conc  
(4)N55E 24.78 SW Cor Culv 1982 Lapham LCRC#279 Fd 1/2" Iron  
Headwall Wit-(8)East Fe Cor 31.02  
(9)N40W P.P. 88.00  
(10)S30W Cable Marker 46.85
- 1960 Edmands Eng. Work dwg 1983 Lapham  
Wit-same as (3) & (4) Set #50 spike from prev survey  
Wit-(11)S60E Nail Top of Post 75.00  
(12)N60E Center R/W Marker 66.05  
(13)N50W SW Cor Bridge Deck 31.30
- 1997 Lapham Set P.K. Nail  
Wit-(14)N45E 76.53 16" Willow  
(15)N55E 66.00 Top Cen Hwy Mon  
(16)N45W 38.15 NW Cor Conc  
Tube Wall  
(17)S50W 74.10 4" Ash
- 1998 MDOT Fd P.K. Nail  
See MDOT Plans#26011 for Loc & Wits

**B. Description of corner evidence found and/or method applied in restoring or re-establishing corner:**

Found P.K. Nail in centerline M-18, corner post and fence to West 7 feet North, and centerline of road to East 3 feet South. Nail agrees with witnesses (10), (11), (12) & (13). Also agrees with measurements by MSHD 1938; Lapham 1976 and 1990; and MDOT 1998 to K-13 and K-11.

See dossier for detailed report.

APPROVED LAND CORNER

P.A. 345 of 1990


Gladwin County

Co. Rep. [Signature]  
Date 10/30/98

**C. Description of monument for corner and accessories established to perpetuate locating the position of the corner:**

K-12: 1/4 Corner common to Sections 35 & 36. Set 5/8" x 18" rerod in Monument Box with Gladwin County Remonumentation cap marked P.S.#27458.

Witnesses:  
S50°W 4" Ash, nail & tag, 74.10' (MDOT)  
N50°W SW Corner Bridge Deck 31.30'  
S45°E 8" Ash, nail & tag, 86.82' N.B.T.

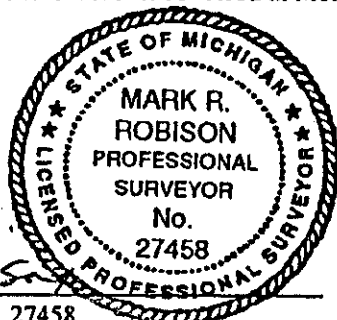

N55°E, P.K. Nail, Top Ctr R/W Marker 66.00' (MDOT)  
N45°W NW Corner Tube Wall 38.15' (MDOT)

Signed by [Signature]  
Surveyor's Michigan License No. 27458

Date 11-16-99