

GLADWIN COUNTY REMONUMENTATION

LAND CORNER RECORDATION CERTIFICATE
Filing Requirement of Act 74, Mich. P.A. 1970

UBER 001 PAGE 159

For corners in

GLADWIN

(County)

Located In:

Corner Code #

- | | | |
|------------------------------------|--------------------------|------------|
| 1. Public Land Survey | T <u>18N</u> R <u>2W</u> | <u>M-5</u> |
| | T ___ R ___ | _____ |
| | T ___ R ___ | _____ |
| | T ___ R ___ | _____ |
| 2. Property Controlling in Section | S ___ T ___ R ___ | _____ |
| | S ___ T ___ R ___ | _____ |
| 3. Miscellaneous Property in Sec. | S ___ T ___ R ___ | _____ |
| | S ___ T ___ R ___ | _____ |

STATE OF MICHIGAN
GLADWIN COUNTY
FILED -Remonumentation

17 OCT 97 1:17 P.M.

BONNIE K. HOUSE
REGISTER OF DEEDS

Register of Deeds Stamp & File Number

4. Lot No. _____, Recorded Plat _____
5. Private Claims _____

I, MARK R. ROBISON, in a field survey on May 22, 19 97 do hereby state that under requirements of P.A. 74, Michigan P.A. of 1970, the corner points mentioned in lines 1 and 2 above were in conformance with regulations and rules therefore as required in the current manual of survey instructions of the United States Department of the Interior, Bureau of Land Management or by a decree of a Court of Law and /or that the corner points mentioned in lines 3, 4 and 5 above were in conformance with the rules of the Michigan Board of Land Surveyors or by a Decree of a Court of Law; established, re-established, monumented, recovered, found as expressed below:

NOTE: Not more than 2 corners, all in the same town and range, may be recorded on this certificate.

	A	B	C	D	E	F	G	H	I	J	K	L	M
1													
2		6		5		4		3		2		1	
3													
4		7		8		9		10		11		12	
5													
6		18		17		16		15		14		13	
7													
8		19		20		21		22		23		24	
9													
10		30		29		28		27		26		25	
11													
12		31		32		33		34		35		36	
13													

A. Description of original monument and accessories and/or subsequent restoration:

- | | |
|---|---|
| 1877 T. Gale Merrill
Set Post
Wit-(1)S1E 16 links 8" Cedar
(2)N80E 30 links 6" Maple | 1978 +/- Corner Reset from '76 survey
1981 Lapham survey & working dwg.
Found capped iron |
| 1956 Moore survey
Wit-(3)12" Oak N30W 99.6'
(4)12" Oak S50E 69.7' | 1983 Lapham survey & working dwg. |
| 1976 Corner Found
Section Subd for Gladwin Cemetery | 1989 Lapham survey
Wit-none |

APPROVED LAND CORNER
P.A. 345 of 1990
Gladwin County

Co. Rep. [Signature]
Date 9/25/97

B. Description of corner evidence found and/or method applied in restoring or reestablishing corner:

Found capped iron #9433 in centerline of constructed trail road East of river in low wooded area. Set Gladwin County Re-mon in place of found iron.

See dossier for detailed report.

C. Description of monument for corner and accessories established to perpetuate locating the position of the corner:

M-5: Corner on township line, common to Sections 12 & 13.
Set 5/8" x 36" rerod with Gladwin County Re-mon Cap marked P.S.#27458.


- Witnesses:
S75W 18" Cedar, nail & tag, 40.20'
N05E 12" Ash, nail & tag, 27.15'
S08E 12" Ash, nail & tag, 36.86'
N30W 8" Maple, nail & tag, 46.70'
Corner common to Sections 7 & 18, T18N, R1W.

SURVEY &
REMONUMENTATION

JAN 08 1998

SECTION

Signed by [Signature]
Surveyor's Michigan License No. 27458

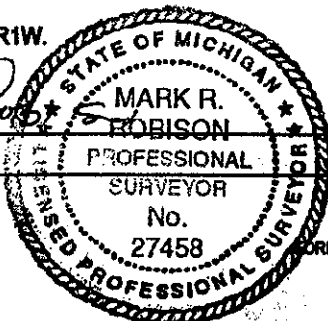

Date 10-7-97