

SURVEY & REMONUMENTATION

DEC 01 1999

LAND CORNER RECORDATION CERTIFICATE
Filing Requirement of Act 74, Mich. P.A. 1970
Gladwin County Remonumentation

LIBER **001** PAGE **286**

SECTION

For Corners in

GLADWIN

(County)

Located In:

Corner Code#:

- | | | |
|---------------------------------------|----------------------------|-------------|
| 1. Public Land Survey | T. <u>18N</u> R. <u>2W</u> | <u>M-13</u> |
| | T. _____ R. _____ | _____ |
| | T. _____ R. _____ | _____ |
| 2. Public Controlling in Section | S. _____ T. _____ R. _____ | _____ |
| | S. _____ T. _____ R. _____ | _____ |
| 3. Miscellaneous Property in Section | S. _____ T. _____ R. _____ | _____ |
| | S. _____ T. _____ R. _____ | _____ |
| 4. Lot No. _____, Recorded Plat _____ | | |
| 5. Private Claims _____ | | |

STATE OF MICHIGAN
 GLADWIN COUNTY
 FILED-REMONUMENTATION

19 NOV 1999 2:05:11 PM

BONNIE K. HOUSE
 REGISTER OF DEEDS

Register of Deeds Stamp & File Number

I, Mark R. Robison, in a field survey on July 7, 1999, do hereby certify that under requirements of P.A. 74, Michigan P.A. of 1970, the corner points mentioned in lines 1 and 2 above were in conformance with regulations and rules therefore as required in the current manual of survey instructions of the United States Department of the Interior, Bureau of Land Management or by a decree of a Court of Law and/or that the corner points mentioned in lines 3, 4 and 5 above were in conformance with the rules of the Michigan Board of Land Surveyors or by a Decree of a Court of Law, established, re-established, monumented, re-monumented, recovered, found as expressed below.

	A	B	C	D	E	F	G	H	I	J	K	L	M
1													
2	6	5	4	3	2	1							
3													
4	7	8	9	10	11	12							
5													
6	18	17	16	15	14	13							
7													
8	19	20	21	22	23	24							
9													
10	30	29	28	27	26	25							
11													
12	31	32	33	34	35	36							
13													

NOTE: Not more than 2 corners, all in the same town and range, may be recorded on this certificate.

A. Description of original monument and accessories and/or subsequent restoration:

- | | | |
|--|---|---|
| 1831 Harvey Parke
Set Temp'y Post for Cor of
Towns 17 & 18 N, R1 & 2W
Wit-(1) Aspen 9 N19W 19
(2) Pine 11 S1W 31 | 1973 Lapham (T17N, R2W)
LCRC#65 & survey
Found 1/2" Rod
Wit-(3) East (North) 33.80 P.P.
(4) N30W (meas. N70W) 32.80
White Pine
(5) S80W (meas S10E) 111.50
W. Oak Tree | 1984 Lapham (T17N, R1W)
survey
Wit-same as (3), (4) & (5) |
| 1969 Lapham
working drawing (T18N, R2W)
Wit-none | 1980 Lapham (T17N, R2W)
2 surveys
Wit-same as (3), (4) & (5) | 1991 Lapham (T17N, R1W)
survey
Wit-same as (3), (4) & (5) |
| | 1982 Lapham (T17N, R2W)
survey
Wit-same as (3), (4) & (5) | 1994 Lapham (T17N, R1W)
survey
Wit-same as (3), (4) & (5) |

B. Description of corner evidence found and/or method applied in restoring or re-establishing corner:

Found P.K. Nail over 1/2" pipe in 18" well point in centerline of road, opposite survey line to South. Agrees with witnesses (4) & (5). Also agrees with Lapham surveys (1982 & 1994). Set 5/8" x 36" iron in place of found well point for true corner. See dossier for detailed report.

APPROVED LAND CORNER

P.A. 345 of 1990.
 Gladwin County


Co. Rep. [Signature]
 Date July 28, 1999

C. Description of monument for corner and accessories established to perpetuate locating the position of the corner:

M-13: Set 5/8" x 36" rerod with Gladwin County Remonumentation cap marked P.S.#27458 in Monument Box.

Witnesses:

- N60°W 21" White Pine, nail & tag, 32.85'
- S45°W 14" White Pine, nail & tag, 52.00'
- S20°E Triple 18" Oak, nail & tag in East Tree, 111.30'
- N60°E 3" Maple, nail & tag, 68.55'

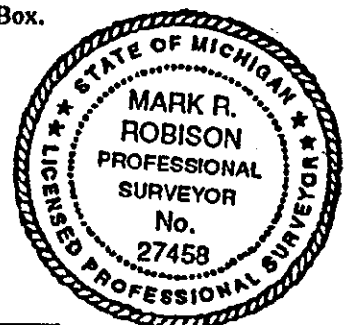

Signed by [Signature]
 Surveyor's Michigan License No. 27458

Date 11-16-99