

FEB 18 1994

PAGE 07

LAND CORNER RECORDATION CERTIFICATE
Filing Requirement of Act 74, Mich. P.A. 1970

DEC 29 '93 AM


For corners in COMMISSION

GLADWIN
(County)

Located In:

Corner Code #/

- | | | | | | |
|---------------------------------------|---|-----|---|----|-----|
| 1. Public Land Survey | T | 19N | R | 1E | E-3 |
| | T | | R | | |
| | T | | R | | |
| | T | | R | | |
| 2. Property Controlling
in Section | S | | T | R | |
| | S | | T | R | |
| 3. Miscellaneous
Property in Sec. | S | | T | R | |
| | S | | T | R | |
4. Lot No. _____, Recorded Plat _____
5. Private Claims _____

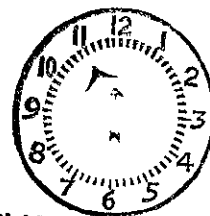

GLADWIN COUNTY
REGISTER OF DEEDS
Y. Lounsbury

Register of Deeds Stamp & File Number

I, PAUL B. LAPHAM, in a field survey on OCTOBER, 19 93, do hereby certify that under requirements of P.A. 74, Michigan P.A. of 1970, the corner points mentioned in lines 1 and 2 above were in conformance with regulations and rules therefore as required in the current manual of survey instructions of the United States Department of the Interior, Bureau of Land Management or by a decree of a Court of Law and/or that the corner points mentioned in lines 3, 4 and 5 above were in conformance with the rules of the Michigan Board of Land Surveyors or by a Decree of a Court of Law; established, re-established, monumented, re-monumented, recovered, found as expressed below:

NOTE: Not more than 4 corners, all in the same town and range, may be recorded on this certificate.


	A	B	C	D	E	F	G	H	I	J	K	L	M
2	6		5		4		3		2		1		
3													
4	7		8		9		10		11		12		
5													
6	18		17		16		15		14		13		
7													
8	19		20		21		22		23		24		
9													
10	30		29		28		27		26		25		
11													
12	31		32		33		34		35		36		
13													

- A. Description of original monument and accessories and/or subsequent restoration:
 1846 JOHN MULLETT, INT. PRINCIPAL MERIDIANS 12.52' N. OF QR. SEC. POST P.117
 11-30-62 GILBERT, 1" PIPE IN MON. BOX, M.S.H.D. WITNESS CARD
 N 85°W, 49.69' - 8" POPLAR
 N 52°E, 99.75' - 18" POPLAR
 S 32°E, 77.79' - 6" JACK PINE
 04-01-74 McGINNIS, FOUND NAIL (132) 01-404
 09-25-74 McGINNIS, FOUND NAIL (132) 01-499
 06-02-77 McGINNIS, MON. BOX W/ 5/8" BAR LCRC 187
 05-17-93 D.F. LEDY, 1/2" PIPE IN MON. BOX (132) 2-588

- B. Description of corner evidence found and/or method applied in restoring or reestablishing corner:
 FOUND 5/8" ROD IN MONUMENT BOX IN M-30 Q. EXCAVATED TO 3' DEPTH, FOUND NO OTHER EVIDENCE.
 FOUND RECORDED WITNESSES:
 S 75°E, 36.55' - FENCE POST (REC. S 75°W)
 EAST, 39.45' - 7" PINE
 EAST, 39.72' - SPIKE, 8" JACK PINE
 S.E., 64.10' - SPIKE, 5" JACK PINE
 S.W., 65.15' - SPIKE, 6" JACK PINE
 WEST, 49.60' - SPIKE, 9" POPLAR

This Corner established in Gladwin County Remonumentation Program.
See dossier for detailed report.

- C. Description of monument for corner and accessories established to perpetuate locating the position of the corner:
 SET 5/8" X 36" RE-ROD WITH 2" GLADWIN COUNTY MONUMENT CAP IN MONUMENT BOX.
 EAST, 39.72' - SPIKE, 8" JACK PINE
 S 37°E, 64.10' - SPIKE, 5" JACK PINE
 S 50°W, 65.15' - SPIKE, 6" JACK PINE
 WEST, 49.60' - SPIKE, 9" POPLAR

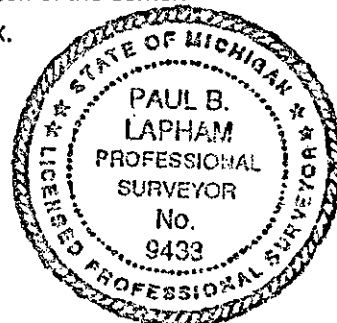

Signed by Paul B. Lapham Date 12.08.93
 Surveyor's Michigan License No. 9433