

FEB 18 1994

DEC 29 '93 AM


COMMISSION

LAND CORNER RECORDATION CERTIFICATE

Filing Requirement of Act 74, Mich. P.A. 1970

For corners in

GLADWIN (County)	Located In:	Corner Code =#
1. Public Land Survey	T 19N R 1E	E-7
	T _____ R _____	_____
	T _____ R _____	_____
	T _____ R _____	_____
2. Property Controlling in Section	S _____ T _____ R _____	_____
	S _____ T _____ R _____	_____
3. Miscellaneous Property in Sec.	S _____ T _____ R _____	_____
	S _____ T _____ R _____	_____
4. Lot No. _____, Recorded Plat _____		
5. Private Claims _____		

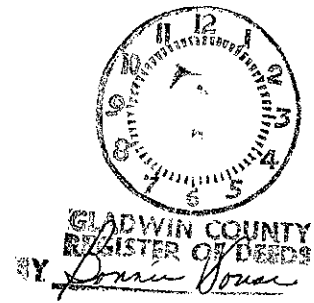

Register of Deeds Stamp & File Number

I, PAUL B. LAPHAM, in a field survey on OCTOBER, 19 93, do hereby certify that under requirements of P.A. 74, Michigan P.A. of 1970, the corner points mentioned in lines 1 and 2 above were in conformance with regulations and rules therefore as required in the current manual of survey instructions of the United States Department of the Interior, Bureau of Land Management or by a decree of a Court of Law and/or that the corner points mentioned in lines 3, 4 and 5 above were in conformance with the rules of the Michigan Board of Land Surveyors or by a Decree of a Court of Law; established, re-established, monumented, re-monumented, recovered, found as expressed below:

	A	B	C	D	E	F	G	H	I	J	K	L	M
2	6	5	4	3	2	1							
3													
4	7	8	9	10	11	12							
5													
6	18	17	16	15	14	13							
7													
8	19	20	21	22	23	24							
9													
10	30	29	28	27	26	25							
11													
12	31	32	33	34	35	36							
13													

NOTE: Not more than 4 corners, all in the same town and range, may be recorded on this certificate.

A. Description of original monument and accessories and/or subsequent restoration:

- 1846 JOHN MULLETT, INT. PRINC. MERIDIANS, 13.50 N. OF 1/4 SEC. POST P.115
FIR 10" S 13°E 29 LKS
B. ASH 14" N 04°E, 26 LKS
- 11-30-62 GILBERT, 1" PIPE IN MON. BOX, M.S.H.D. WITNESS CARD
N 50°W, 89.94' - 6" POPLAR
S 50°W, 60.49' - 6" W. BIRCH
S 37°E, 81.97' - 6" W. PINE
- 01-14-92 C.F. ROSER, FOUND 3/4" IRON IN MON. BOX LCRC #336


B. Description of corner evidence found and/or method applied in restoring or reestablishing corner:

- FOUND 5/8" x 36" BAR IN MON. BOX 40' NORTH OF Q SECOND DAM ROAD IN Q M-30.
EXCAVATED TO 3-1/2' DEPTH, FOUND ORIGINAL GROUND AT 3', FOUND NO OTHER EVIDENCE.
- FOUND RECORDED WITNESSES:
N 55°W, 90'± BADLY ROTTED POPLAR STUMP

This Corner established in Gladwin County Remonumentation Program.
See dossier for detailed report.

C. Description of monument for corner and accessories established to perpetuate locating the position of the corner:

- SET 5/8" x 36" RE-ROD WITH 2" GLADWIN COUNTY MONUMENT CAP IN MONUMENT BOX.
N 45°E, 60.65' - 10" WHITE PINE
N 55°W, 87.70' - 12" WHITE PINE
S 85°W, 56.90' - 5" RED OAK
S 20°E, 71.70' - CEN. M.H. COVER IN ASPHALT

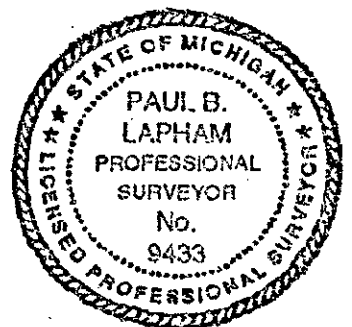

Signed by Paul B. Lapham
Surveyor's Michigan License No. 9433

Date 12/08/93