LAND CORNER RECORDATION CERTIFICATE

Filing Requirement of Act 74, Mich. P.A. 1970

For corners in
GLADWIN
(County)

	Located In:	Corner Code ##
1. Public Land Survey	T 19N R 1E	E-7,E-8,F-7
	T ___ R ___	
	T ___ R ___	
	T ___ R ___	
2. Property Controlling	S 21 T ___ R ___	1
in Section	S ___ T ___ R ___	
3. Miscellaneous	S ___ T ___ R ___	
Property in Sec.	S ___ T ___ R ___	

Register of Deeds Stamp & File Number

4. Lot No. _____ , Recorded Plat _____
5. Private Claims _____

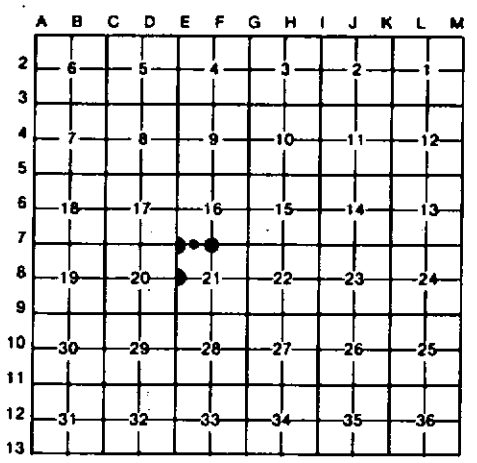

I, C.F. ROSER , in a field survey on 02-02 , 19 91 , do hereby certify that under requirements of P.A. 74, Michigan P.A. of 1970, the corner points mentioned in lines 1 and 2 above were in conformance with regulations and rules therefore as required in the current manual of survey instructions of the United States Department of the Interior, Bureau of Land Management or by a decree of a Court of Law and/or that the corner points mentioned in lines 3, 4 and 5 above were in conformance with the rules of the Michigan Board of Land Surveyors or by a Decree of a Court of Law; established, re-established, monumented, re-monumented, recovered, found as expressed below:

NOTE: Not more than 4 corners, all in the same town and range, may be recorded on this certificate.

A. Description of original monument and accessories and/or subsequent restoration:

E-7 E-8 F-7 1

STATE OF MICHIGAN
CARL F. ROSER
LAND SURVEYOR
No. 12028
REGISTERED LAND SURVEYOR

B. Description of corner evidence found and/or method applied in restoring or reestablishing corner:

E-7
FD 3/4" IR IN MON BOX (COVER GONE) FOR CLOSING CORNER COMMON TO SEC'S 16 & 21. ON MICH MERIDIAN. CTR OF M-6, 27.5' WIDE. BIT RD(M-30) IS 2.4' WEST. CTR OF NEW BIT SURFACE RD TO EAST. IS 40'± SOUTH.

E-8
ESTABLISHED WEST 1/4 COR OF SEC 21 (ON MICH MERIDIAN) ON LINE BETWEEN THE SE COR OF SEC 13(T19N-R1W) AND THE NW COR OF SEC 21(T19N-R1E) AND MIDWAY BETWEEN THE NW & SW COR'S OF SEC 21. FD OLD 1 3/16"x 4.6' SOLID ROUND SHAFT, N68°28'W, 58.2'. N'LY EDGE OF SUGAR RIVER IS 312'± EAST. CTR OF M-30 (IN CURVE) IS 262'± WEST.

F-7
FD 3/8" REROD FOR N 1/4 COR OF SEC 21; DROVE 1"x 15" GALV. IR PIPE (OVER SAME) W/LS CAP IN 1" PIPE; TOP IS 1" DEEP BELOW BIT. RD SURFACE. CTR E-W BIT RD IS 0.8' SOUTH. 24" CMP (X-CULV) IS 17'-E. 24"CMP (X-CULV) IS 84'-W.

1
ESTAB. SW COR OF SE-SW OF SEC 16, ON LINE BETWEEN THE S 1/4 AND SW COR OF S-16 AND AT PROPORTIONATE MEA TO G.L.O. (RUN-OUT SECTION) CORNER FALLS IN OLD E-W W-W FN REMAINS. CTR OF NEW BIT SURFACE RD IS 40' SOUTH.

C. Description of monument for corner and accessories established to perpetuate locating the position of the corner:

E-7
FD 3/4" IRON ROD IN MON BOX.

13"W.PINE	N55°W	87.22'
10"ASH	N70°E	50.02'
7"ASH	S30°E	139.80'

E-8
SET DNR MON & CEDAR POST.

4"W.PINE	N10°W	7.6'
POWER POLE	N50°E	70.72'
5"W.BIRCH(CLP-3)	S30°E	8.9'
3"W.PINE	S45°W	5.2'

F-7
FD 3/8" REROD; DROVE 1"x 15" GALV. PIPE W/LS CAP.

6"ASH	NW	80.74'
10"W.BIRCH	N55 E	118.91'
14"ASH	S20 E	76.54'
8"MAPLE	S15 W	57.89'
SET CEDAR POST W/LOC TAG	NORTH	50'

1
DROVE 5/8"x 34" REROD W/LS CAP & SET CEDAR POST W/LOC TAG.

11"BALSAM	N60°W	7.4'
13"ASH	N15°E	32.0'
8"TW.MAPLE	N60°E	19.0'

Signed by Carl F. Roser 1-14-92 Date _____

Surveyor's Michigan License No. 12028

FORM APPROVED BY MICHIGAN STATE BOARD OF LAND SURVEYORS, JAN. 28, 1971
REVISED MAY 14, 1975
REVISED JAN., 1983