LAND CORNER RECORDATION CERTIFICATE

Filing Requirement of Act 74, Mich. P.A. 1970

For corners in
GLADWIN
(County)

	Located in:	Corner Code ##
1. Public Land Survey	T 19N R 1E	G-9,G-8
	T ___ R ___	
	T ___ R ___	
	T ___ R ___	
2. Property Controlling	S 21 T ___ R ___	12,14
in Section	S ___ T ___ R ___	
3. Miscellaneous	S ___ T ___ R ___	
Property in Sec.	S ___ T ___ R ___	

Register of Deeds Stamp & File Number

4. Lot No. _____ , Recorded Plat _____
5. Private Claims _____

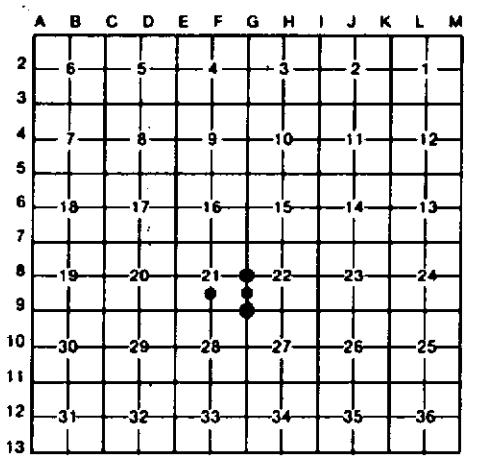

I, C.F. ROSER , in a field survey on 02-02 , 19 91 , do hereby certify that under requirements of P.A. 74, Michigan P.A. of 1970, the corner points mentioned in lines 1 and 2 above were in conformance with regulations and rules therefore as required in the current manual of survey instructions of the United States Department of the Interior, Bureau of Land Management or by a decree of a Court of Law and/or that the corner points mentioned in lines 3, 4 and 5 above were in conformance with the rules of the Michigan Board of Land Surveyors or by a Decree of a Court of Law; established, re-established, monumented, re-monumented, recovered, found as expressed below:

NOTE: Not more than 4 corners, all in the same town and range, may be recorded on this certificate.

~~A. Description of original monument and accessories and/or subsequent restoration:~~

G-9 G-8 12 14

-- C CONT --
FD 3/8" REROD
S00°04'58"W 1499.22'
FD 3/8" REROD (PROB. N1/4
S-27) S00°04'58"W 2626.28'
FD CONC MON S89°36'09"E 438.12'
FD 3/4" PIPE
(1/8 COR) S89°36'09"E 1315.27'

B. Description of corner evidence found and/or method applied in restoring or reestablishing corner:

G-9
-- C CONT --
FD EDMANDS ENGR. IR (S1/4 COR, S-22) S89°40'00"E 2623.04'
DROVE 5/8"x 34" REROD W/LS CAP 012028(1/8 COR)
N00°02'34"E 1314.78'
SET DNR MON (E 1/4 COR. S-21) N00°02'34"E 2629.56'

G-8
RESTABLISHED E 1/4 S-21 M.O.L. BETWEEN SEC COR'S TO N & S. FD LATH & HUB W/PK. S55°W. 2.9'. TOP OF BANK TO TITTABAWASSEE RV (DECENDS STEEP BANK E TO EDGE RV) IS 115'± EAST. N EDGE OF POWER LINE CLEARING IS 15'± SOUTH. CTR OF E-W POWER LINE (WOOD POLES) IS 90' SOUTH.

12
ESTAB. SW COR OF N 1/2-SE 1/4 OF S-21 PER STD B.L.M. INSTRUCTIONS. DRIVABLE JEEP TRAIL (TURN-AROUND TO WEST) IS 405' NORTH.

14
ESTAB. SE COR OF N 1/2-SE 1/4 OF S-21 PER STD B.L.M. INSTRUCTIONS.

C. Description of monument for corner and accessories established to perpetuate locating the position of the corner:

G-9
NOTHING SET, COMP. POINT ONLY; COR FALLS IN TITTABAWASSEE RV. (SMALLWOOD LAKE).
CALC. TIES TO FD IR'S FROM COMP. SE S-21:
FD 1/2" REROD BY P.LAPHAM N88°05'51"W 787.44'
FD S1/4 S-21 P.LAPHAM IR. N88°04'12"W 2602.50'
-- CONT C ABOVE --

G-8
SET DNR MON & CEDAR POST.

5"MAPLE(CLP-3)	N70°W	4.2'
9"MAPLE	N10°E	26.4'
13"TN.MAPLE	N45°E	17.5'
POWER POLE	S05°W	90.02'

12
DROVE 5/8"x 34" REROD W/LS CAP & SET CED POST W/LOC TAG.

8"MAPLE(CLP-3)	N25°W	25.4'
3"W.PINE	N20°E	30.5'
3"MAPLE	S50°E	7.2'
4"MAPLE	S60°W	15.3'

14
DROVE 5/8"x 34" REROD W/LS CAP & SET CED POST W/LOC TAG.

4"MAPLE	N35°W	7.3'
6"MAPLE	N25°E	3.0'
5"MAPLE(CLP-3)	S40°W	7.2'
5"MAPLE	S65°E	7.0'

Signed by Carl F. Roser 01-14-92 Date _____
12028
Surveyor's Michigan License No. _____

STATE OF MICHIGAN
CARL F. ROSER
LAND SURVEYOR
No. 12028
REGISTERED LAND SURVEYOR

FORM APPROVED BY MICHIGAN STATE BOARD OF SURVEYORS JAN. 28, 1971
REVISED MAY 14, 1975
REVISED JAN., 1983