

DEC 1 6 1996

COMMISSION

GLADWIN COUNTY REMONUMENTATION

LAND CORNER RECORDATION CERTIFICATE
Filing Requirement of Act 74, Mich. P.A. 1970

LIBER 001 PAGE 108

For corners in

GLADWIN
(County)

Located In:

Corner Code #

- 1. Public Land Survey T 19N R 1W B - 11
- T R
- T R
- T R
- 2. Property Controlling S T R
- in Section S T R
- 3. Miscellaneous S T R
- Property in Sec. S T R

STATE OF MICHIGAN
GLADWIN COUNTY
FILED-REMONUMENTATION

2 DEC 96 3:24 P.M.

BONNIE K. HOUSE
REGISTER OF DEEDS

Register of Deeds Stamp & File Number

- 4. Lot No. _____, Recorded Plat _____
- 5. Private Claims _____

I, MARK ROBISON, in a field survey on November, 1996, do hereby state that under requirements of P.A. 74, Michigan P.A. of 1970, the corner points mentioned in lines 1 and 2 above were in conformance with regulations and rules therefore as required in the current manual of survey instructions of the United States Department of the Interior, Bureau of Land Management or by a decree of a Court of Law and/or that the corner points mentioned in lines 3, 4 and 5 above were in conformance with the rules of the Michigan Board of Land Surveyors or by a Decree of a Court of Law; established, re-established, monumented, recovered, found as expressed below:

NOTE: Not more than 2 corners, all in the same town and range, may be recorded on this certificate.

A	B	C	D	E	F	G	H	I	J	K	L	M
1												
2	6	5	4	3	2	1						
3												
4	7	8	9	10	11	12						
5												
6	18	17	16	15	14	13						
7												
8	19	20	21	22	23	24						
9												
10	30	29	28	27	26	25						
11	●											
12	31	32	33	34	35	36						
13												

A. Description of original monument and accessories and/or subsequent restoration:

- 1877 T. GALE MERRILL WIT.-SAME AS (3),(4)&(5)
- SET 1/4 POST 1991 PAUL LAPHAM
- WIT.-(1)MAPLE 18 N67W 28 UNRECORDED L.C.R.C. FOR
- (2)HEMLOCK 12 S15W 37 COUNTY ROAD CONSTRUCTION
- 1950 EDMANDS-WORKING DRAWING FOUND 1/2" REROD
- 1981 PAUL LAPHAM WIT.-(6)N50E 6" R. PINE 56.30
- SET C.I. OPPOSITE FENCE NORTH (7)S05E 3" R. PINE 44.20
- WIT.(3)SOUTH 33 C.I. (8)S45W 3" R. PINE 55.90
- (4)NORTH FE. COR. 29.15 (9)NORTH COR. POST 33.35
- (5)N40E 4" PINE 38.34
- 1981 PAUL LAPHAM SURVEY

APPROVED LAND CORNER
P.A. 915 of 1990
Gladwin County

Co. Rep. [Signature]
Date 11/4/96

B. Description of corner evidence found and/or method applied in restoring or reestablishing corner:


FOUND 1/2" X 18" REROD IN C/L OF COUNTY ROAD 1.5' BELOW SURFACE, OPPOSITE FENCES NORTH & SOUTH; FOUND REMAINS OF YELLOW CAP, MATCHED WITNESS (8), (7) & (9), REMOVED AND SET GLADWIN RE-MON FROM FOUND IRON AND WITNESSES.

SEE DOSSIER FOR DETAILED REPORT.

C. Description of monument for corner and accessories established to perpetuate locating the position of the corner:

B-11: 1/4 CORNER COMMON TO SECTIONS 30 & 31.
SET 5/8" X 36" REROD WITH GLADWIN CO. RE-MON CAP MARKED P.S.#27458

- WITNESSES:
- N50E R. PINE N&T 56.30'
- S05W R. PINE N&T 44.20'
- S45W R. PINE N&T 55.90'
- NORTH COR. POST N&T 33.35'

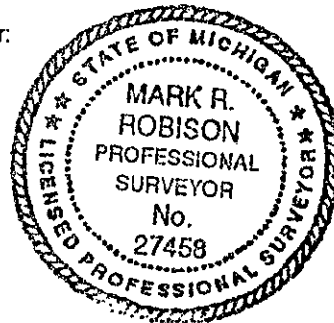

Signed by Mark R. Robison
Surveyor's Michigan License No. 27458

Date 11-29-96